IREDELL COUNTY HEALTH DEPARTMENT

STATESVILLE 704-878-5305 MOORESVILLE 704-664-5281

IMPROVEMENT PERMIT / AUTHORIZATION TO CONSTRUCT / OPERATION PERMIT / EXISTING SYSTEM INSPECTION

PERMIT# 83804 PIN# 4776422362 DATE 9-17-99

OWNER OR CONTRACTOR Hipolito Guevera PHONE: Business 872 3412 Home

ADDRESS 209 James Dr. Cleveland N.C.

LOCATION 64E TL Swann TL McAllister at end on left

SUBDIVISION BLOCK / SECTION LOT LOT AREA 1.75 acres SITE CLASS PS DESIGN FLOW 360 L.T.A.R. .3

Septic Tank: 1000 Gallons; STB 760 Date 8-19-99
Pump Tank: Gallons; PT Date
Pump Make: Model Serial No.
Nitrification Field: No Fields 1 Square Feet 1200 Linear Feet 400
No Lines 3 Trench Width 36" Max Trench Bottom Depth 24" Gravel Depth 12"

(X) New System ( ) Repair System Type: (I) II. III. IV. V. VI
System Description: Conv. Gravity
Repair System Description:
Maintenance Agreement Required: ( ) Yes (X) No
( ) Slab ( ) Crawl Space ( ) Basement w/plumbing ( ) Basement wo/plumbing


( ) House/Mod. Home No. Bedrooms 3
( ) Mobile Home No. Bathrooms 2
( ) Business No. Employees
( ) Other

Water Supply: ☐ Individual ☒ Public ☐ Community


Comments/Conditions:

Comments/Conditions

INITIAL SITE SKETCH

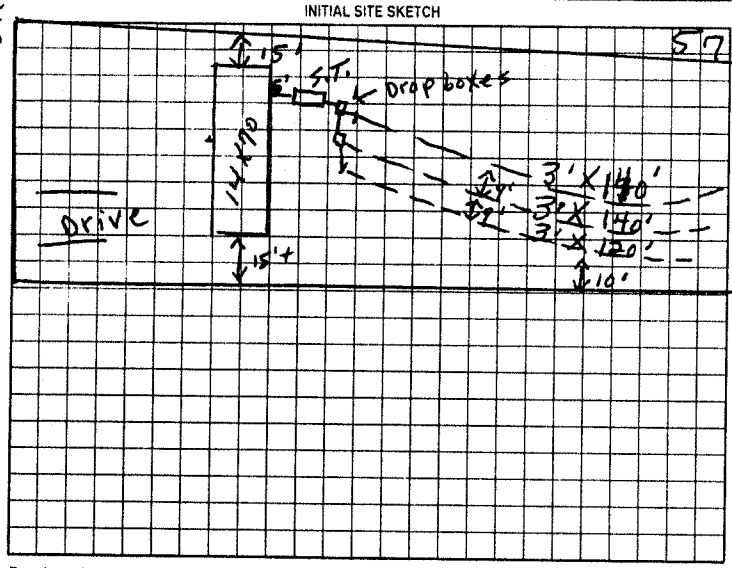

AS BUILT SKETCH

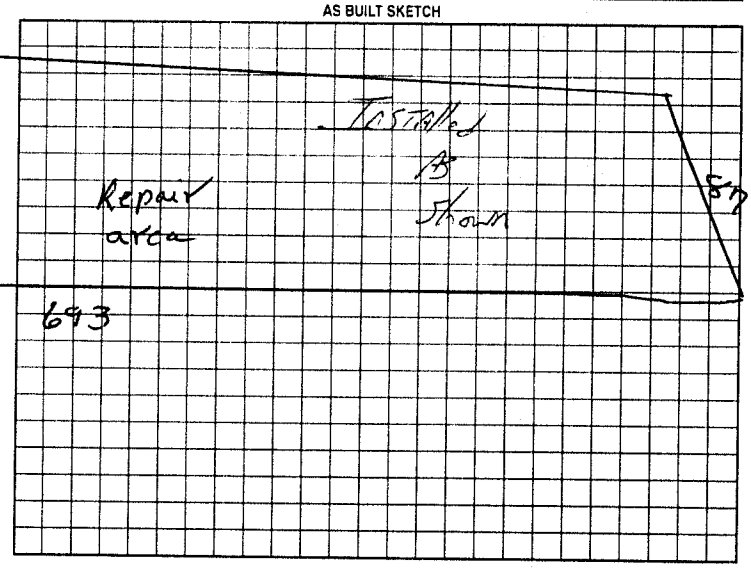

Permit can be suspended or revoked if any false information is supplied toward securing the permit/any unauthorized changes are made to the site/any unauthorized changes are made in the installation of the system. Improvement Permit with plat valid without expiration. Improvement Permit with site plan valid for sixty months. Authorization to Construct is valid for a period equal to that of Improvement Permit – not to exceed sixty months.

Signed: X Gary Bryan agent for Hipolito Guevara date

Improvement Permit by: R.C. Moore date 9-17-99

Authorization to Construct by: R.C. Moore date 9-17-99

Installed by: Powell Brothers

Operation Permit by: C. Potter date Oct 7, 99

Existing System Inspection by: date

HEALTH DEPT. COPY: WHITE OWNER COPY (FINAL): YELLOW OWNER COPY (INITIAL): PINK

McAllister RL