IREDELL COUNTY HEALTH DEPARTMENT

STATESVILLE 704-878-5305 MOORESVILLE 704-664-5281

IMPROVEMENT PERMIT / AUTHORIZATION TO CONSTRUCT / OPERATION PERMIT / EXISTING SYSTEM INSPECTION

PERMIT# 82198 PIN# 4776260244 DATE 7-29-99

OWNER OR CONTRACTOR William A. Ramseur PHONE: Business _____ Home 872 8405

ADDRESS 204 mcallister Rd

LOCATION 64E, TL Swann TL mcAllister TL Lexanne at end

SUBDIVISION Lex White Est BLOCK / SECTION _____ LOT 7 LOT AREA .6 acres SITE CLASS PS DESIGN FLOW 360 L.T.A.R. .32

Septic Tank: 1000 Gallons; STB 794 Date 4-5-99
Pump Tank: _____ Gallons; PT _____ Date _____
Pump Make: _____ Model _____ Serial No. _____
Nitrification Field: No Fields 1 Square Feet 870 Linear Feet 290
No Lines 3 Trench Width 36" Max Trench Bottom Depth 36" Gravel Depth N/A

[x] New System [ ] Repair System Type: I, II, [III], IV, V, VI
System Description: Gravity 25% Redu
Repair System Description: pump to " "
Maintenance Agreement Required: [ ] Yes [x] No


[ ] House/Mod. Home No. Bedrooms 3
[x] Mobile Home No. Bathrooms 2
[ ] Business No. Employees _____
[ ] Other _____
[ ] Slab [x] Crawl Space [ ] Basement w/plumbing [ ] Basement wo/plumbing

Water Supply: [ ] Individual [x] Public [ ] Community


Comments/Conditions:

Comments/Conditions: Lexanne Circle

INITIAL SITE SKETCH

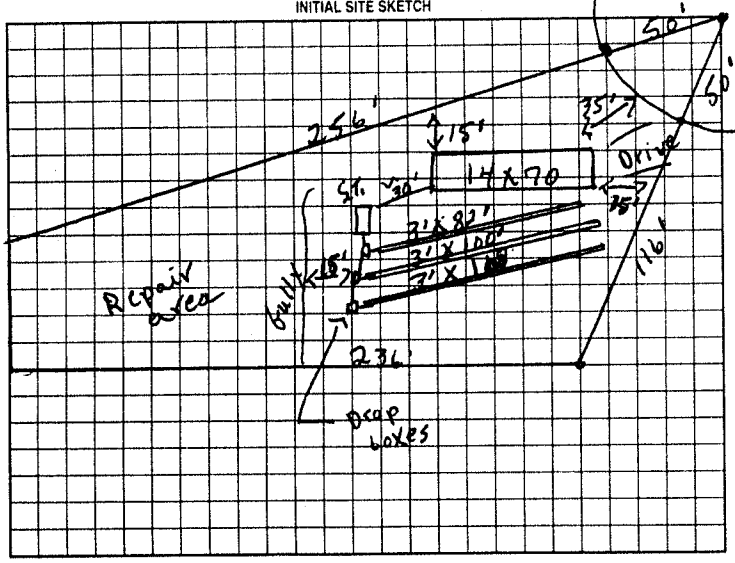

AS BUILT SKETCH

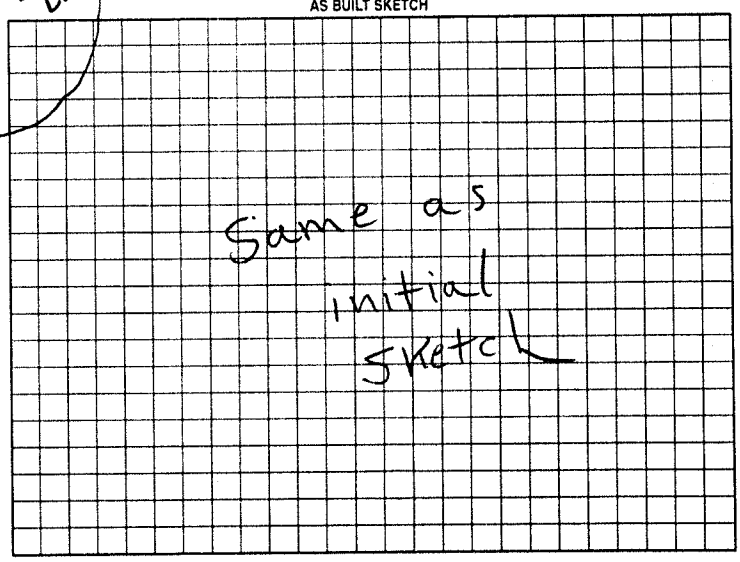

Permit can be suspended or revoked if any false information is supplied toward securing the permit/any unauthorized changes are made to the site/any unauthorized changes are made in the installation of the system. Improvement Permit with plat valid without expiration. Improvement Permit with site plan valid for sixty months. Authorization to Construct is valid for a period equal to that of Improvement Permit – not to exceed sixty months.

Signed: William A. Ramseur date 7-30-99 Installed by: Tucker Grading

Improvement Permit by: P. C. Moore date 7-29-99 Operation Permit by: P. C. Moore date 9-16-99

Authorization to Construct by: P. C. Moore date 7-29-99 Existing System Inspection by: _____ date _____

HEALTH DEPT. COPY WHITE OWNER COPY (FINAL) YELLOW OWNER COPY (INITIAL) PINK