IREDELL COUNTY HEALTH DEPARTMENT

STATESVILLE 704-878-5305 MOORESVILLE 704-664-5281

IMPROVEMENT PERMIT / AUTHORIZATION TO CONSTRUCT / OPERATION PERMIT / EXISTING SYSTEM INSPECTION

EXISTING

PERMIT# Repair PIN# DATE 2-9-01

OWNER OR CONTRACTOR CASE FARMS ([redacted]) PHONE: Business (704) 528-4501 Home

ADDRESS 127 SHAMROCK LANE, STATESVILLE, NC

LOCATION HWY 64 E (L) SWANN RD. (R) McALISTER (L) SHAMROCK LANE TO END

SUBDIVISION BLOCK / SECTION LOT LOT AREA SITE CLASS DESIGN FLOW 360 GPD L.T.A.R.

Septic Tank: ~~1050~~ Gallons: STB 620 Date 3-30-01

Pump Tank: Gallons: PT Date

Pump Make: Model Serial No

Nitrification Field: No Fields 1 Square Feet 1080 Linear Feet 360'

No Lines 3 Trench Width 3' Max Trench Bottom Depth 24 Gravel Depth 12"

☐ New System ☑ Repair System Type: I (II) III IV V VI

System Description:

Repair System Description: CONVENTIONAL

Maintenance Agreement Required: ☐ Yes ☑ No

☐ Slab ☑ Crawl Space ☐ Basement w/plumbing ☐ Basement wo/plumbing

☐ House/Mod. Home No. Bedrooms 3

☐ Mobile Home No. Bathrooms

☐ Business No. Employees


☐ Other

Water Supply: ☑ Individual ☐ Public ☐ Community


Comments/Conditions: ① PUMP AND CRUSH/FILL EXISTING SEPTIC TANK ② TIE ALL WATER (GREY WATER) INTO NEW SEPTIC TANK ③ INSTALL DRAINLINES UNIFORM AND ON CONTOUR.

Comments/Conditions 2nd Line has 9½" Fall every 10', Meets State Rule. USED EXISTING TANK & SANITARY TEE - INSTALLED NEW drainfield & New Tank with Zebel ~~Filter~~ installed for Grey Water Tank Risers Installed

INITIAL SITE SKETCH

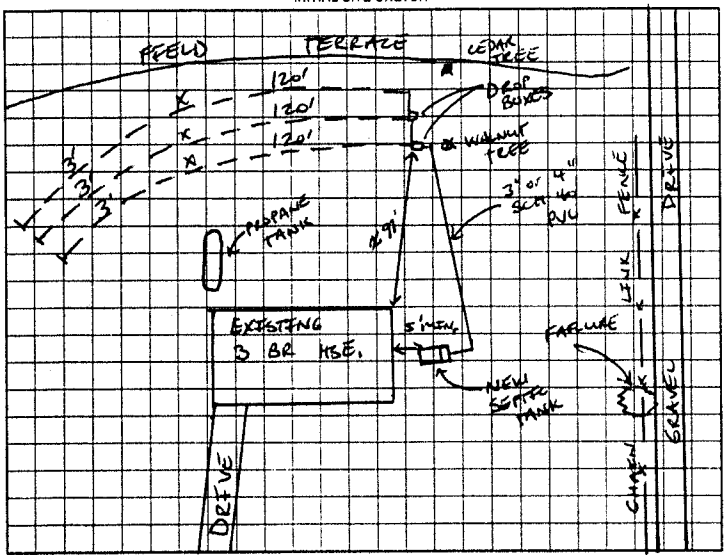

AS BUILT SKETCH

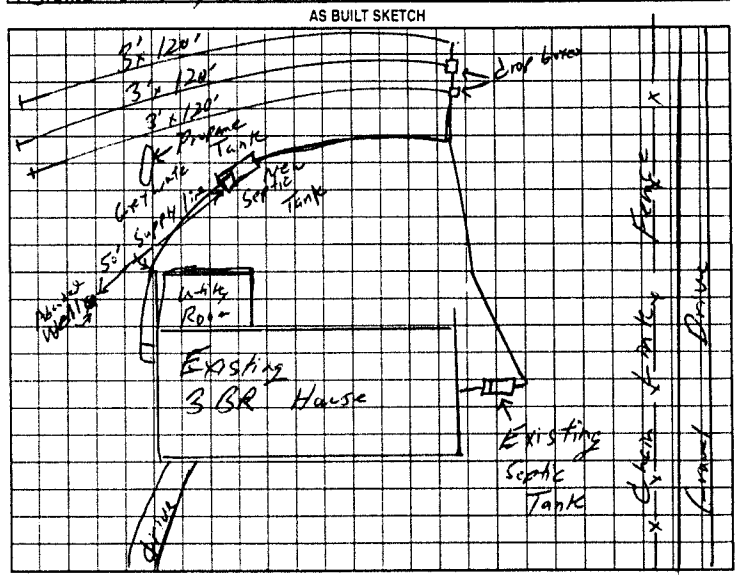

Permit can be suspended or revoked if any false information is supplied toward securing the permit/any unauthorized changes are made to the site/any unauthorized changes are made in the installation of the system. Improvement Permit with plat valid without expiration. Improvement Permit with site plan valid for sixty months. Authorization to Construct is valid for a period equal to that of Improvement Permit – not to exceed sixty months.

Signed: David J. Reavis date 2/27/01

Improvement Permit by: [signature] date 2/9/01

Authorization to Construct by: [signature] date 2/9/01

Installed by: SAMMY BEAVERS

Operation Permit by: Tim Cook REHS date 5-8-01

Existing System Inspection by: date

HEALTH DEPT. COPY WHITE OWNER COPY (FINAL) YELLOW OWNER COPY (INITIAL) PINK