IREDELL COUNTY HEALTH DEPARTMENT

STATESVILLE 704-878-5305 MOORESVILLE 704-664-5281

IMPROVEMENT PERMIT / AUTHORIZATION TO CONSTRUCT / OPERATION PERMIT / EXISTING SYSTEM INSPECTION

PERMIT# 095638 PIN# 4776 52 2526 DATE 5-18-01

OWNER OR CONTRACTOR DONALD BREEDLOVE PHONE: Business 704 878-3155 Home

ADDRESS PO BOX 254 STATESVILLE, NC 28687

LOCATION HWY 64E, © SWANN, © MCALISTER, 150 YARDS ON LEFT PAST CASE FARMS

SUBDIVISION BLOCK / SECTION LOT LOT AREA 2.0 AC SITE CLASS. B DESIGN FLOW 360 L.T.A.R. .3

Septic Tank: 1000 Gallons: STB 1012 Date 10-26-01
Pump Tank: Gallons, PT Date
Pump Make: Model Serial No
Nitrification Field: No Fields Square Feet 1200 Linear Feet 400'
No Lines 5 Trench Width 36" Max Trench Bottom Depth 36" Gravel Depth 12"

X New System Repair System Type I II III IV V VI
System Description: CONV GRAV
Repair System Description GRAV/PUMP 2546 PED
Maintenance Agreement Required. Yes No


X House/Mod Home No. Bedrooms 3
Mobile Home No. Bathrooms 2
Business No. Employees
Other
Slab X Crawl Space Basement w/plumbing Basement wo/plumbing

Water Supply: Individual X Public Community


Comments/Conditions: ① INSTALL LINES ON CONTOUR AS FLAGGED OUT ② MAINTAIN SETBACKS

Comments/Conditions -Poly Lok Filter Installed
- Septic Tank Liner Installed

INITIAL SITE SKETCH

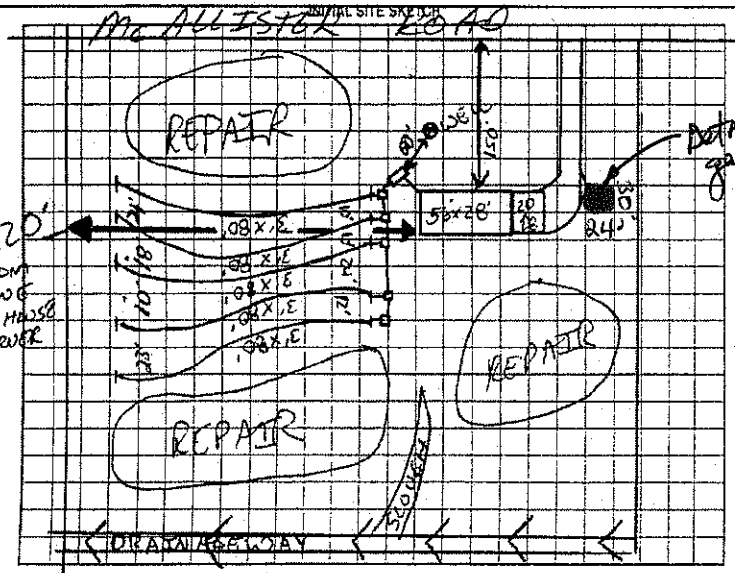

AS BUILT SKETCH

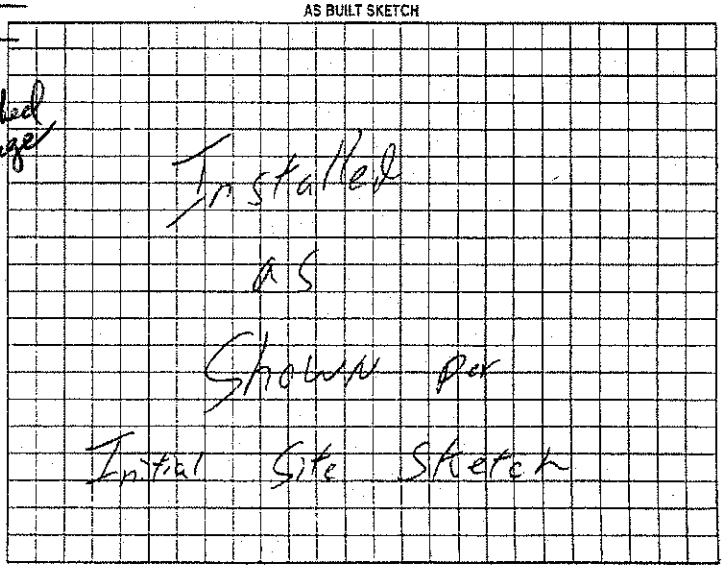

Permit can be suspended or revoked if any false information is supplied toward securing the permit;any unauthorized changes are made to the site;any unauthorized changes are made in the installation of the system. Improvement Permit with plat valid without expiration. Improvement Permit with site plan valid for sixty months. Authorization to Construct is valid for a period equal to that of Improvement Permit – not to exceed sixty months.

Signed: Donald E Breedlove date 5/21/01 Installed by: David Yount

Improvement Permit by: [signature] date 5-18-01 Operation Permit by: William O Johnson date 1/11/02

Authorization to Construct by: [signature] date 5-18-01 Existing System Inspection by: date

HEALTH DEPT COPY WHITE OWNER COPY (FINAL) YELLOW OWNER COPY (INITIAL) PINK

Location of the proposed 24X30' detached garage addition does not appear to impact the existing on-site septic system.NOTE:**

[signature]

Date: 8-15-13

ICHD-Environmental Health Division