IREDELL COUNTY HEALTH DEPARTMENT

Statesville Phone TR 3-7271 Mooresville Phone NO 3-1271

PERMIT TO INSTALL SEPTIC TANK

Permit NO. 71 Permit Date DEC 3 1970

Owner JOHN TURNER Address Rt. 1 STATESVILLE, N.C.

Installed By LACKEY BROS. Address STONY POINT, N.C.


Location of Property 64 E, LEFT ON Rd # 2155 - THEN LEFT ON # 2182 BEHIND 4th HOUSE

Tank		Capacity		Length of Lines		Fixtures	
Block	( )	1000	(✓)	225'	(✓)	No. of Baths	(1)
Precast	(✓)	1250	( )	250'	( )	Dishwasher	( )
		1500	( )	Other		Garbage Grdr.	( )
		Other				Other	

NOTIFY HEALTH DEPARTMENT AT LEAST EIGHT HOURS BEFORE TANK IS TO BE INSPECTED.

Final Inspection DEC 3 1970 Approved (✓) Disapproved ( )

Remarks IREDELL WATER Corp.

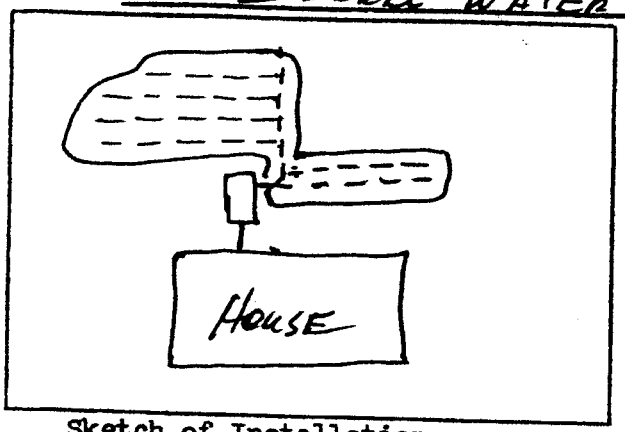

Sketch of Installation

Glenn Ford

Sanitarian