IREDELL COUNTY HEALTH DEPARTMENT

STATESVILLE 704-878-5305 MOORESVILLE 704-664-5281

IMPROVEMENT PERMIT / AUTHORIZATION TO CONSTRUCT / OPERATION PERMIT / EXISTING SYSTEM INSPECTION

PERMIT# 18488 PDN#/PIN# (11E-A-55 Tax map) DATE 4-15-98

OWNER OR CONTRACTOR Gorton Rt Belmont PHONE: Business Home 878 0562

ADDRESS PO Box 5913 Sta

LOCATION 64E TL Stowe Rd TL McAllister TR Eaves 300' Rt.

SUBDIVISION BLOCK / SECTION LOT LOT AREA 2.13 acres SITE CLASS. PS DESIGN FLOW 480 L.T.A.R. .3

Septic Tank: 1000 Gallons; STB 1007 Date 1-18-00
Pump Tank: Gallons; PT Date
Pump Make: Model Serial No.
Nitrification Field: No Fields 1 Square Feet 1600 Linear Feet 533
No Lines 5 Trench Width 36" Max Trench Bottom Depth 36" Gravel Depth 12"

☑ New System ☐ Repair System Type: I, II, III, IV, V, VI
System Description: Conv Gravity
Repair System Description:
Maintenance Agreement Required: ☐ Yes ☑ No


☐ House/Mod. Home No. Bedrooms 4
☑ Mobile Home No. Bathrooms 3
☐ Business No. Employees
☐ Other
☐ Slab ☐ Crawl Space ☐ Basement w/plumbing ☐ Basement wo/plumbing

Water Supply: ☐ Individual ☑ Public ☐ Community


Comments:/Conditions:
Replaces Permit Issued 5-23-96 Going to 4 Bedroom

Comments:/Conditions:

INITIAL SITE SKETCH

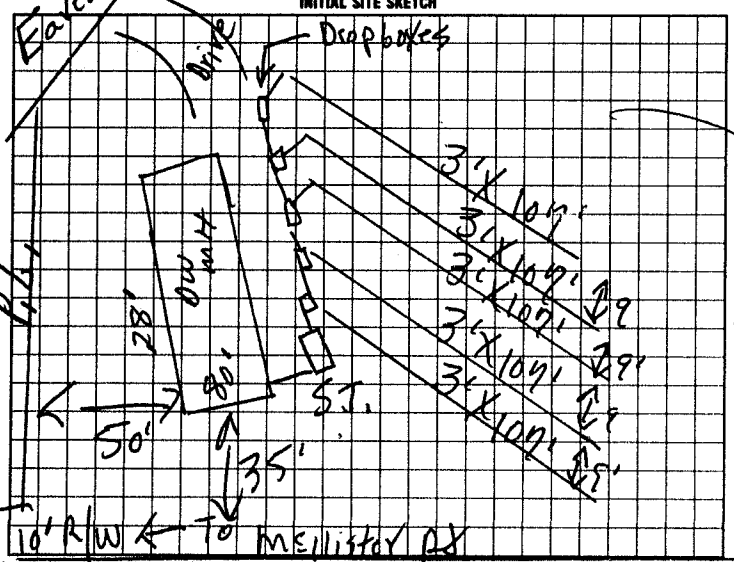

AS BUILT SKETCH

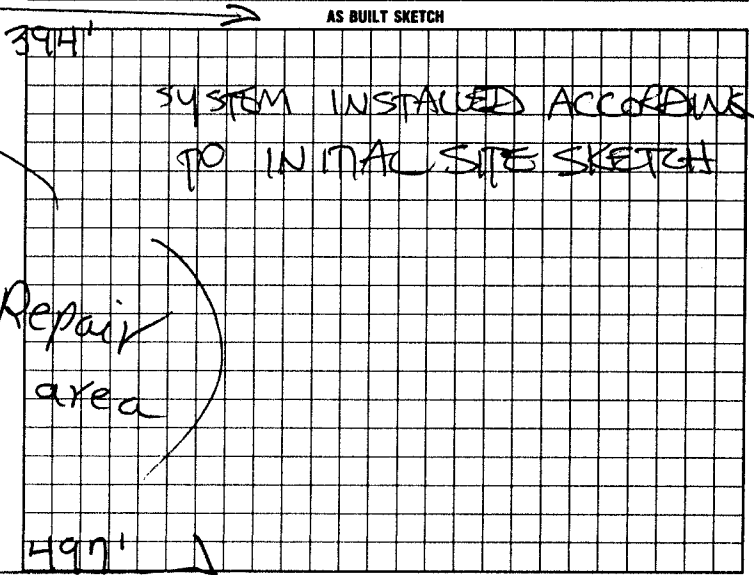

I understand that this permit can be suspended or revoked if any false information is supplied toward securing the permit/any unauthorized changes are made to the site/any unauthorized changes are made in the installation of the system. Improvement Permit with plat valid without expiration. Improvement Permit with site plan valid for sixty months. Authorization to Construct is valid for a period equal to that of Improvement Permit – not to exceed sixty months.

Signed: [signature] B. Gorton Belmont date

Installed by: JAMES HUDDER

Improvement Permit by: P. C. Moore date 4-15-98

Operation Permit by: STEVE HEDRICK date 3-14-00

Authorization to Construct by: P. C. Moore date 4-15-98

Existing System Inspection by: date

HEALTH DEPT. COPY: WHITE INSPECTION COPY (FINAL): GREEN OWNER COPY (FINAL): YELLOW INSPECTION COPY (INITIAL): PINK OWNER COPY (INITIAL): GOLD