53049

# IREDELL COUNTY HEALTH DEPARTMENT

STATESVILLE 704-878-5305 MOORESVILLE 704-664-5281

## IMPROVEMENT PERMIT / CERTIFICATE OF COMPLETION / OPERATION PERMIT / EXISTING SYSTEM INSPECTION

PROPERTY DESCRIPTION NO. 19288 DATE 8-30-94 TAX MAP NO. 11 F-A-35 Watershed: ☐ Yes ☐ No

OWNER OR CONTRACTOR William P. Brewer PHONE: Business Home 872-8065

ADDRESS 405 Swann Rd Statesville, N.C.

LOCATION 64 E TL Swann Rd on left 1.2 miles TL Chimney 1st Drive on Left

SUBDIVISION BLOCK / SECTION LOT LOT AREA 62.65 SITE CLASS PS DESIGN FLOW 480 L.T.A.R. 1.35

Septic Tank: 1000 Gallons; STB 1012 Date 5-8-99

Pump Tank: Gallons; PT Date

Pump Make: Model Serial No.

Nitrification Field: No Fields 1 Square Feet 1380 Linear Feet 460

No Lines 4 Trench Width 36" Max Trench Bottom Depth 24" Gravel Depth 12"

☑ New System ☐ Repair System Type: ☐ I, ☑ II, ☐ III, ☐ IV, ☐ V, ☐ VI

System Description: Conv. Gravity

Repair System Description:

Maintenance Agreement Required: ☐ Yes ☑ No

☑ House/Mod. Home No. Bedrooms 4/5

☐ Mobile Home No. Bathrooms 3

☐ Business No. Employees

☐ Other

☐ Slab ☐ Crawl Space ☐ Basement w/plumbing ☐ Basement w/o plumbing

Water Supply: ☐ Individual ☐ Community ☑ Public


Comments:

Shallow soil in areas keep ditches 24"


Comments:

Note House moved down

INITIAL SITE SKETCH

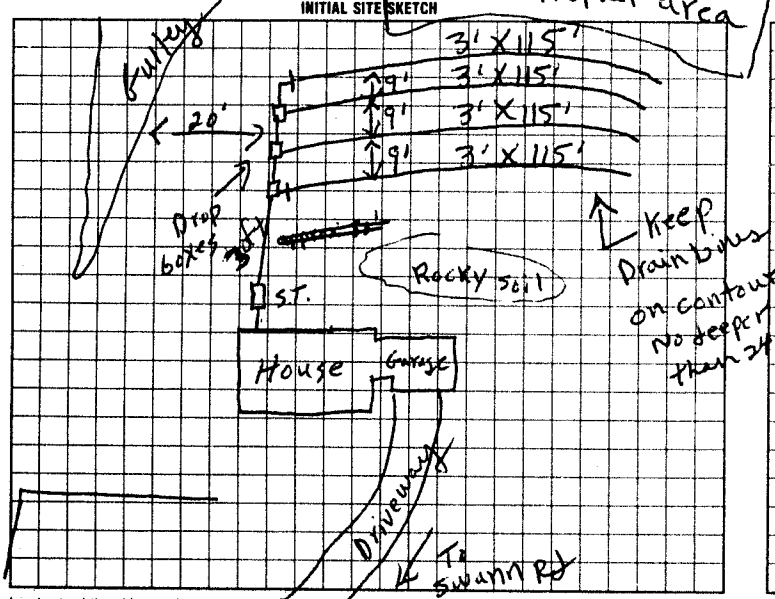


AS BUILT SKETCH

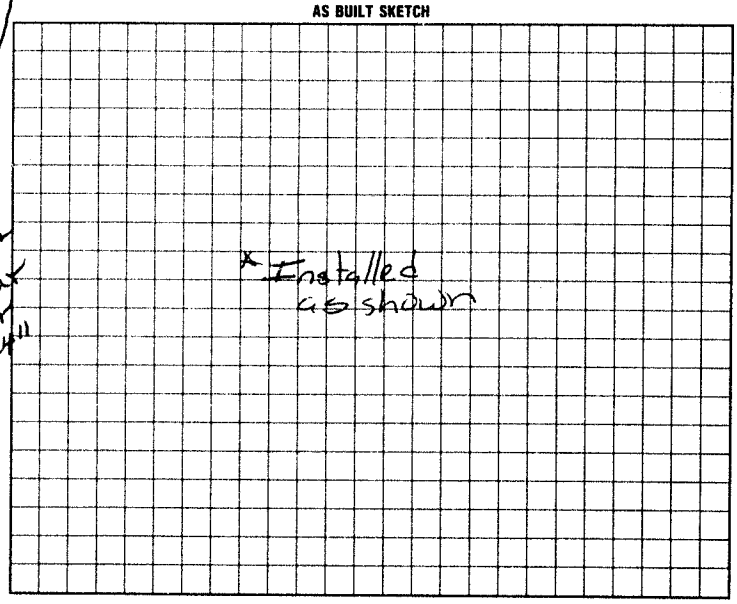


I understand that this permit can be suspended or revoked if any false information is supplied toward securing the permit/any unauthorized changes are made to the site/any unauthorized changes are made in the installation of the system. Improvement Permit is valid for 60 months from date of issuance.

Signed: W. P. Brewer

Improvement Permit by: F. C. Moore date 8-30-94

Existing System Inspection by: date

Installed by: David Yountz

Certificate of Completion by: date

Operation Permit by: Mary C. Ortz RS date 8-1-99

HEALTH DEPT. COPY: WHITE INSPECTION COPY (FINAL): GREEN OWNER COPY (FINAL): YELLOW INSPECTION COPY (INITIAL): PINK OWNER COPY (INITIAL): GOLD