IREDELL COUNTY HEALTH DEPARTMENT

STATESVILLE 704-878-5305 MOORESVILLE 704-664-5281

IMPROVEMENT PERMIT / AUTHORIZATION TO CONSTRUCT / OPERATION PERMIT / EXISTING SYSTEM INSPECTION

PERMIT# 133585 PIN# 4776-61-4883 SONYA LEDWARD - 704-450-0588 DATE 2-22-06

OWNER OR APPLICANT William + SHARON SKINNER PHONE: Business 704-880-4283 Home 704-878-2786

ADDRESS 212 E. BELL ST Statesville NC 28677

LOCATION 64 EAST (L) SWANN RD (L) SWANN CROSSING AT END IN CUL-DE-SAC

SUBDIVISION SWANN CROSSING BLOCK / SECTION ____ LOT 22 LOT AREA 1.843AC SITE CLASS. PS DESIGN FLOW 360 L.T.A.R. .25

Septic Tank: 1000 Gallons; STB 1012 Date 9-26-05
Pump Tank: ____ Gallons; PT ____ Date ____
Pump Make: ____ Model ____ Serial No. ____
Nitrification Field: No Fields 1 Square Feet 1440' Linear Feet 240'
No Lines 5x48' Trench Width 24" Max Trench Bottom Depth 36"

[X] New System [ ] Repair [ ] Expansion System Type: I (II) III IV V VI
System Description: 60AW 50% REDUCT
Repair System Description: LP 50% REDUCTION
Maintenance Agreement Required: [ ] Yes [X] No

[X] House/Mod. Home No. Bedrooms 3
[ ] Mobile Home No. Persons 4
[ ] Business No. Employees ____
[ ] Other ____

Water Supply: [ ] Individual [X] Public [ ] Community


Gravel Depth N/A [X] Gravity [ ] Pressure [ ] Slab [X] Crawl Space [ ] Basement w/plumbing [ ] Basement wo/plumbing

Comments/Conditions: (1) FOR POSITIVE DRAINAGE PERMITS, EXIT WATER / SURFACE WATER TOWARD DRIVEWAY SIDE OF HOUSE (2) HOUSE & SYSTEM IS COMPLETELY FLAGGED OUT, INSTALL LINES ON CONTOURS & MAINTAIN SETBACKS. (3) INSTALL 5 LINES

Comments/Conditions → 48' LONG FED BY A FLOW EQUALIZATION DEVICE SUCH AS A ZOELLER TEE FLO SPLITTER. (4) NO CUTTING, FILLING, OR GRADING OVER SYSTEM AREA AND REPAIR.

INITIAL SITE SKETCH

1" = 50'

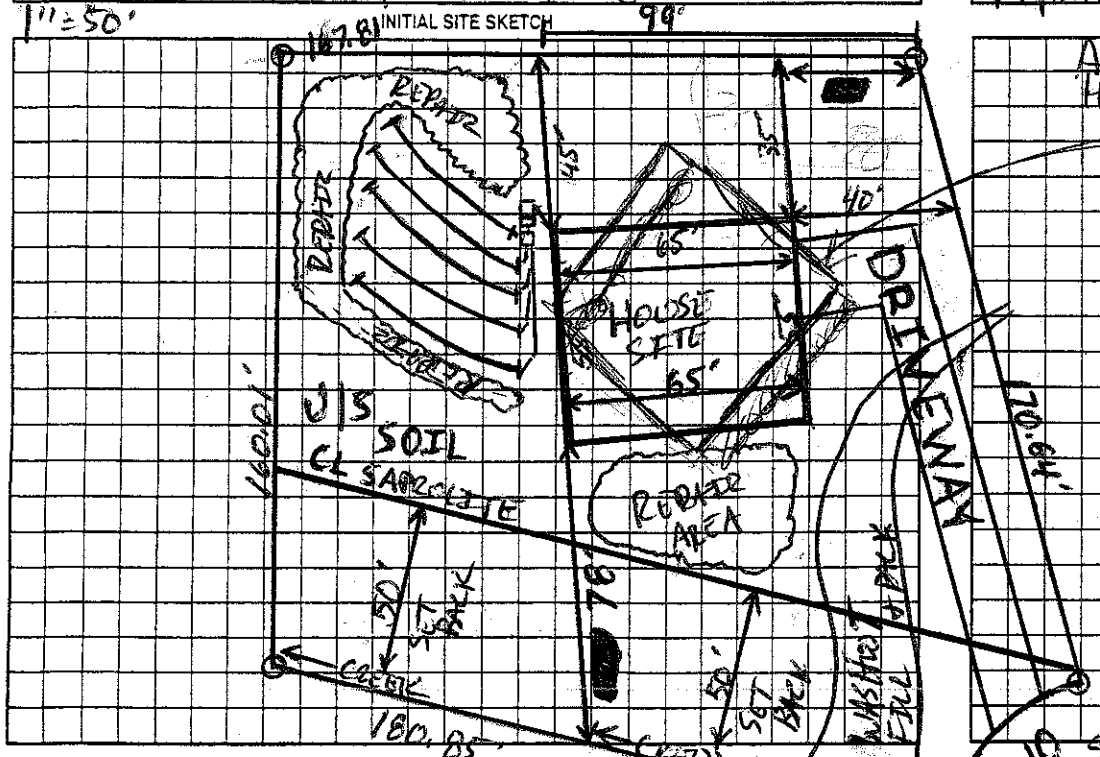

AS BUILT SKETCH

APPROVED 60' X 54' 3 BEDROOM HOME ON 3-10-06
HOUSE NOT BUILT AT TIME OF CHECK, FOUNDATION OF HOME ROTATED AS SKETCHED, SYSTEM UNAFFECTED & STILL HAVE ENOUGH ROOM FOR REPAIR AREA.
OWNER OKAY CHANGES
X William A. Skinner
ADD DOUBLE FLEX MARKUP INSTALLED AS DRAWN

SWANN CROSSING LANE

Permit can be suspended or revoked if any false information is supplied toward securing the permit/any unauthorized changes are made to the site/any unauthorized changes are made in the installation of the system. Improvement Permit with plat valid without expiration. ☐ Improvement Permit with site plan valid for sixty months. ☐ Authorization to Construct is valid for a period equal to that of Improvement Permit – not to exceed sixty months.

Signed: William A Skinner date 2.22.06 Installed by: CLAUDE THOMPSON

Improvement Permit by: [signature] date 2-22-06 Operation Permit by: [signature] date 5-24-06

Authorization to Construct by: [signature] date 3-10-06 Existing System Inspection by: ____ date ____

HEALTH DEPT. COPY: WHITE OWNER COPY (FINAL): YELLOW OWNER COPY (INITIAL): PINK