3.00 (L)

(I) THIS PERMIT REPLACES PREVIOUS ISSUED 1-6-07

IREDELL COUNTY HEALTH DEPARTMENT

STATESVILLE 704-878-5305 MOORESVILLE 704-664-5281

IMPROVEMENT PERMIT / AUTHORIZATION TO CONSTRUCT / OPERATION PERMIT / EXISTING SYSTEM INSPECTION

PERMIT# 139760 PIN# 4776-61-9974 DATE 3-21-07

OWNER OR APPLICANT MEREDITH HOMES PHONE: Business 704-264-5081 Home

ADDRESS ↗ US 64 E. TL SWANN ROAD, TL SWANN CROSSING, 7TH LOT on LEFT

LOCATION ↘ 143 BURTONS BARN LANE, MOORESVILLE, NC, 28115

SUBDIVISION SWANN CROSSING BLOCK / SECTION III LOT 28 LOT AREA 0.548 ACRE SITE CLASS. PS DESIGN FLOW 360 L.T.A.R. 0.30 EPD

Septic Tank: 1000 Gallons; STB 823 Date 9-13-07

Pump Tank: _____ Gallons; PT _____ Date _____

Pump Make: _____ Model _____ Serial No. _____

Nitrification Field: No Fields 1 Square Feet EQ TO 1200 Linear Feet 300

No Lines FOUR Trench Width 24" Max Trench Bottom Depth 36" Stone Depth 24"

☑ New System ☐ Repair ☐ Expansion System Type: I II (III) IV V VI

System Description: 50% REDUCTION GRAVITY

Repair System Description: 50% REDUCTION EQUAL PRESSURE

Maintenance Agreement Required: ☐ Yes ☑ No

☑ Gravity ☐ Pressure

☑ House/Mod. Home No. Bedrooms 3

☐ Mobile Home No. Persons ____

☐ Business No. Employees ____

☐ Other _____


☑ Slab ☐ Crawl Space ☐ Basement w/plumbing ☐ Basement wo/plumbing

Water Supply: ☐ Individual ☑ Public ☒ Community


Comments:/Conditions: INSTALL 50% REDUCTION SYSTEM ON CONTOUR USING 48 PPBPS PANELS.

Comments:/Conditions: Blue Effluent Filter

INITIAL SITE SKETCH

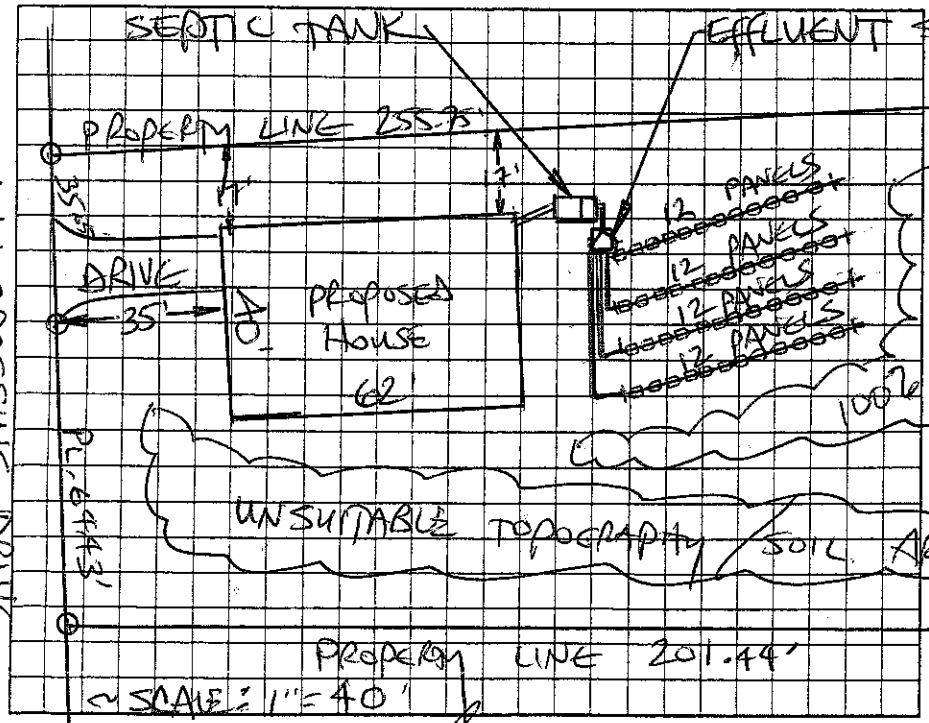

AS BUILT SKETCH

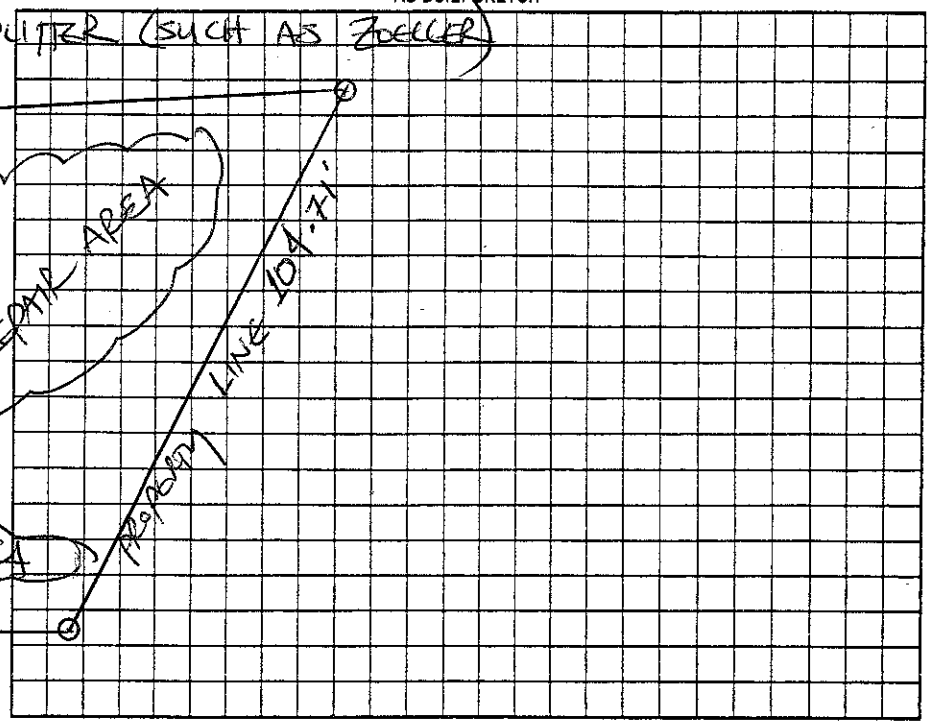

Permit can be suspended or revoked if any false information is supplied toward securing the permit/any unauthorized changes are made to the site/any unauthorized changes are made in the installation of the system. Improvement Permit with plat valid without expiration ☑ Improvement Permit with site plan valid for sixty months ☐ Authorization to Construct is valid for a period equal to that of Improvement Permit – not to exceed sixty months.

Signed: _____ date 3-21-07 Installed by: Rowan Septic

Improvement Permit by: STEVE HEDRICK date 3-21-07 Operation Permit by: _____ date 5-30-07

Authorization to Construct by: STEVE HEDRICK date 3-21-07 Existing System Inspection by: _____ date _____

HEALTH DEPT. COPY: WHITE OWNER COPY (FINAL): YELLOW OWNER COPY (INITIAL): PINK

