IREDELL COUNTY HEALTH DEPARTMENT

Statesville Phone TR 3-7271 Mooresville Phone NO 3-1271

PERMIT TO INSTALL SEPTIC TANK

Permit NO. _____ Permit Date Mar. 19 1966

Owner Buttes Lbr. Co. Address R 3

Installed By C Hoke Address R 1

Location of Property left off 601 S. on Rt ~~off~~

2155 3/4 mile Left ~~off~~ 2182

dirt 1/4 mile on R.


Tank		Capacity		Length of Lines		Fixtures	
Block	( )	1000	( )	225'	( )	No. of Baths	(1)
Precast	( )	1250	( )	250'	( )	Dishwasher	( )
		1500	( )	Other _____		Garbage Grdr.	( )
		Other _____				Other _____	

NOTIFY HEALTH DEPARTMENT AT LEAST EIGHT HOURS BEFORE TANK IS TO BE INSPECTED.

Final Inspection _____ 19__ Approved ( ) Disapproved ( )

Remarks No water this date

Road

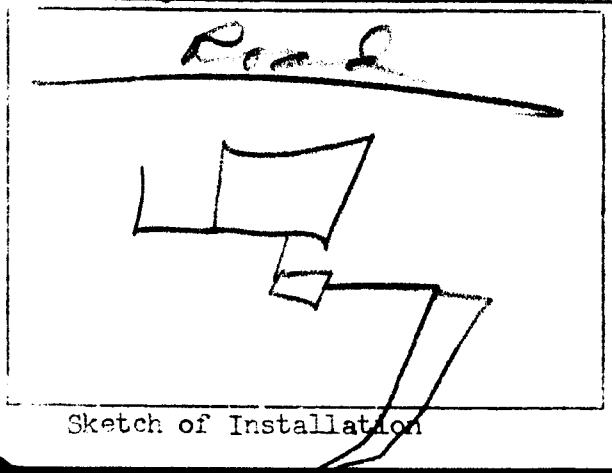

Sketch of Installation

_____

Sanitarian