3:00

IREDELL COUNTY HEALTH DEPARTMENT

STATESVILLE 704-878-5305 MOORESVILLE 704-664-5281

called 6-26-07 @ 10:43

IMPROVEMENT PERMIT / AUTHORIZATION TO CONSTRUCT / OPERATION PERMIT / EXISTING SYSTEM INSPECTION

PERMIT# 139782 PIN# 4776625016 DATE 4-16-07

OWNER OR APPLICANT Spears Builders PHONE: Business 4746625016 Home 704-202-4964

ADDRESS 72 Allendale Circle Huntman NC 28166

LOCATION 64E (L) Swann RD (L) Swann Crossing

SUBDIVISION Swann Crossing BLOCK / SECTION 3 LOT 20 LOT AREA 652 SITE CLASS. PS DESIGN FLOW 360 L.T.A.R. .25

Septic Tank: 1000 Gallons; STB 32 Date 12-4-7
Pump Tank: 1000 Gallons; PT 302 Date 11-6-7
Pump Make: Zoeller Model N152 Serial No.
Nitrification Field: No Fields Square Feet 1440 Linear Feet 360
No Lines 4 Trench Width 36" Max Trench Bottom Depth 30" Gravel Depth ☐ Gravity ☐ Pressure

☑ New System ☐ Repair ☐ Expansion System Type: I II (III) IV V VI
System Description: 25% Pump PM
Repair System Description: 50% LPP Red
Maintenance Agreement Required: ☐ Yes ☐ No

☑ House/Mod. Home ☐ Mobile Home ☐ Business ☐ Other
No. Bedrooms 3
No. Persons
No. Employees


Water Supply: ☐ Individual ☐ Public ☐ Community

☐ Slab ☐ Crawl Space ☐ Basement w/plumbing ☐ Basement wo/plumbing

Comments:/Conditions:
Install on contour - maintain all setbacks
Backfill for positive drainage

Comments:/Conditions:
30" max trench bottom

INITIAL SITE SKETCH

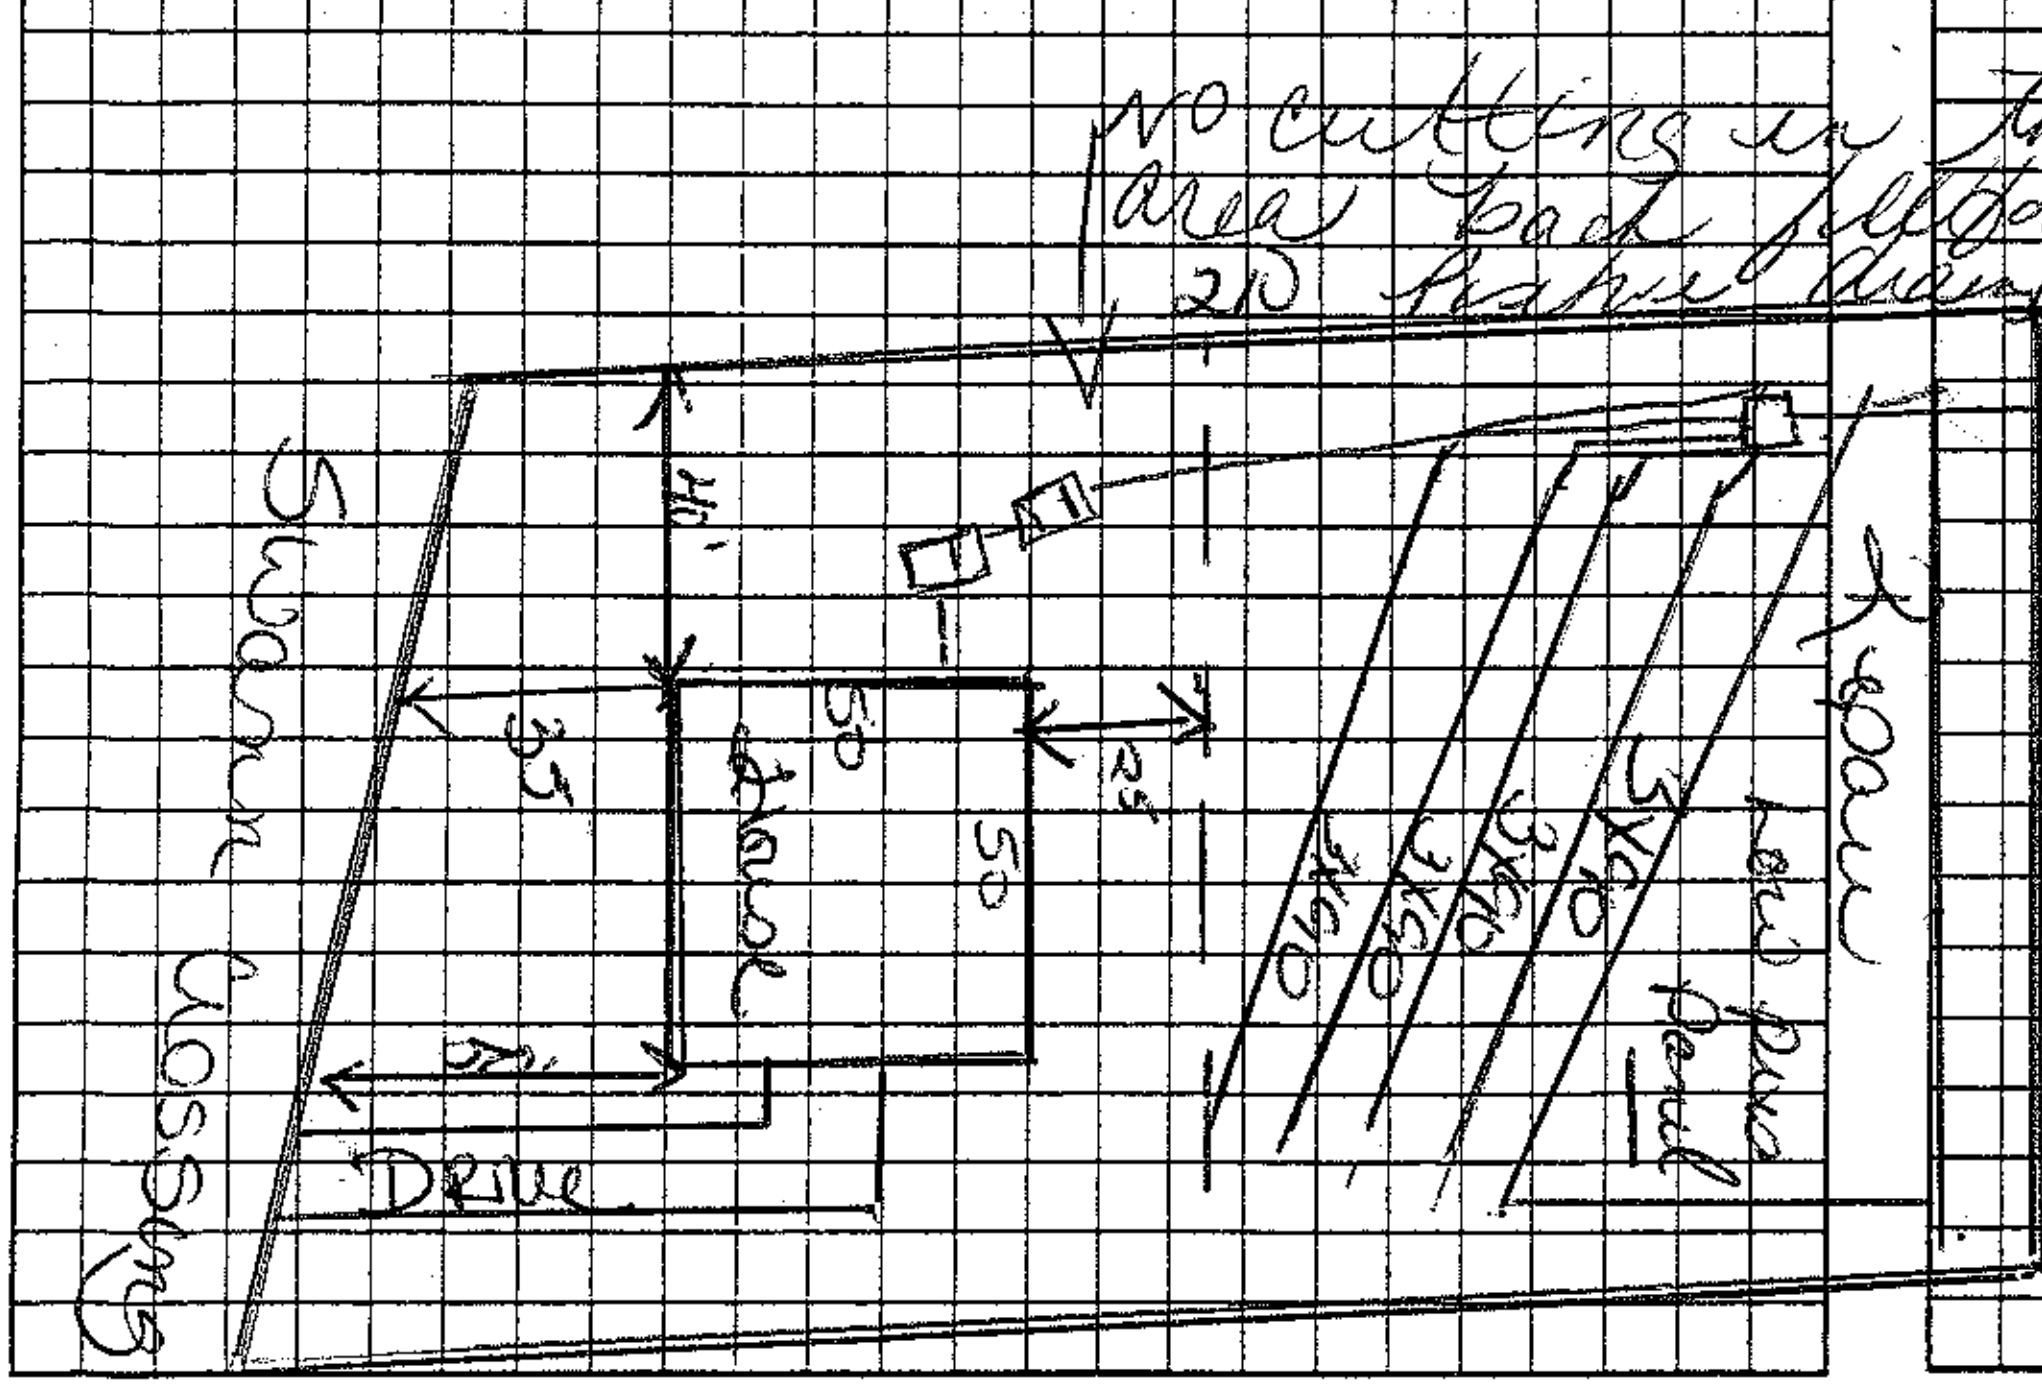

AS BUILT SKETCH

(3) 120'

Permit can be suspended or revoked if any false information is supplied toward securing the permit/any unauthorized changes are made to the site/any unauthorized changes are made in the installation of the system. Improvement Permit with plat valid without expiration ☐ Improvement Permit with site plan valid for sixty months ☐ Authorization to Construct is valid for a period equal to that of Improvement Permit – not to exceed sixty months.

Signed: [signature] date 2-18-07 Installed by: Rowan Booth

Improvement Permit by: Kelly Cook date 4-16-07 Operation Permit by: Kelly Cook date 1-30-08

Authorization to Construct by: Kelly Cook date 9-24-07 Existing System Inspection by: date

HEALTH DEPT. COPY: WHITE OWNER COPY (FINAL): YELLOW OWNER COPY (INITIAL): PINK