Called 6-26-07 @ 10:43

IREDELL COUNTY HEALTH DEPARTMENT

STATESVILLE 704-878-5305 MOORESVILLE 704-664-5281

IMPROVEMENT PERMIT / AUTHORIZATION TO CONSTRUCT / OPERATION PERMIT / EXISTING SYSTEM INSPECTION

PERMIT# 139781 PIN# 4776625260 DATE 4-16-07

OWNER OR APPLICANT Spear Builders PHONE: Business 704-202-4464 Home

ADDRESS 172 Allendale Circle Troutman, NC 28166

LOCATION left east (D) Summit RD (D) Summit Crossing

SUBDIVISION Summit Crossing BLOCK / SECTION 3 LOT 19 LOT AREA .759 SITE CLASS. #5 DESIGN FLOW 360 L.T.A.R. .3

Septic Tank: 1000 Gallons: STB 825 Date 11-24-07

Pump Tank: 1000 Gallons: P.T 302 Date 11-08-07

Pump Make: Cruiser Model Sav25 5HP Serial No. 7571M

Nitrification Field: No Fields ___ Square Feet 1200 Linear Feet 350

No Lines 3 Trench Width 36" Max Trench Bottom Depth 36" Gravel Depth ___

☑ New System ☐ Repair ☐ Expansion System Type: I II III IV V VI

System Description: 25% Pump

Repair System Description: 25% Pump

Maintenance Agreement Required: ☐ Yes ☐ No

☑ House/Mod. Home ☐ Mobile Home ☐ Business ☐ Other

No. Bedrooms 3 No. Persons ___ No. Employees ___

Water Supply: ☐ Individual ☑ Public ☐ Community

☐ Gravity ☑ Pressure ☐ Slab ☑ Crawl Space ☐ Basement w/plumbing ☐ Basement wo/plumbing


Comments:/Conditions:

Backfill for positive drainage


Comments:/Conditions:

Unstall on contour
Maintain all setbacks

INITIAL SITE SKETCH

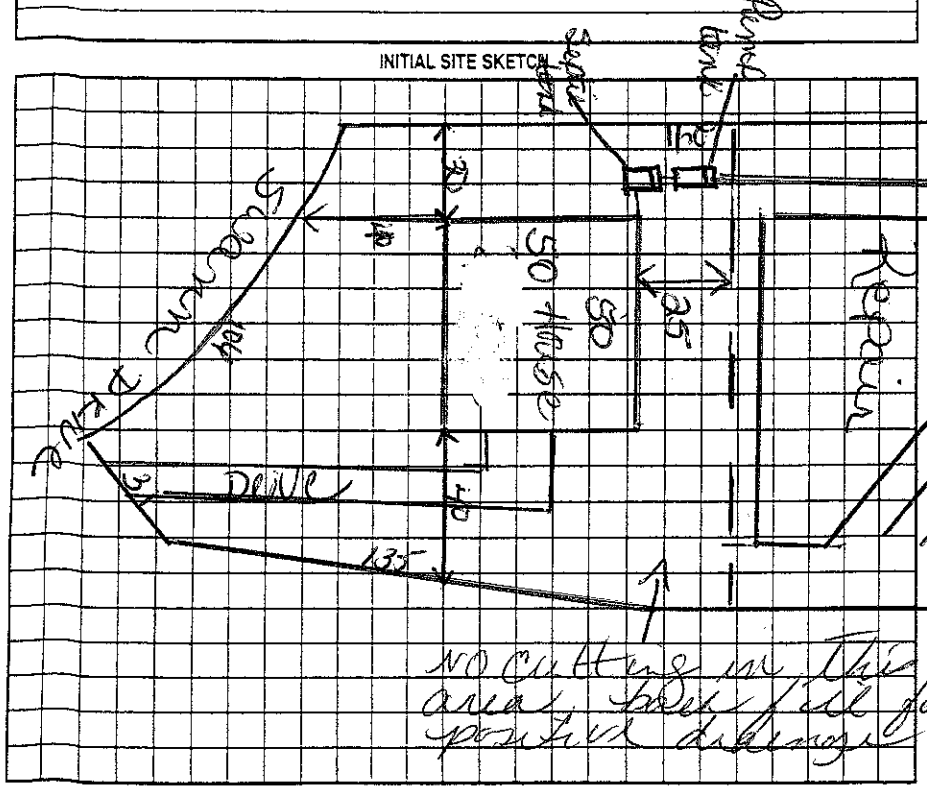

AS BUILT SKETCH

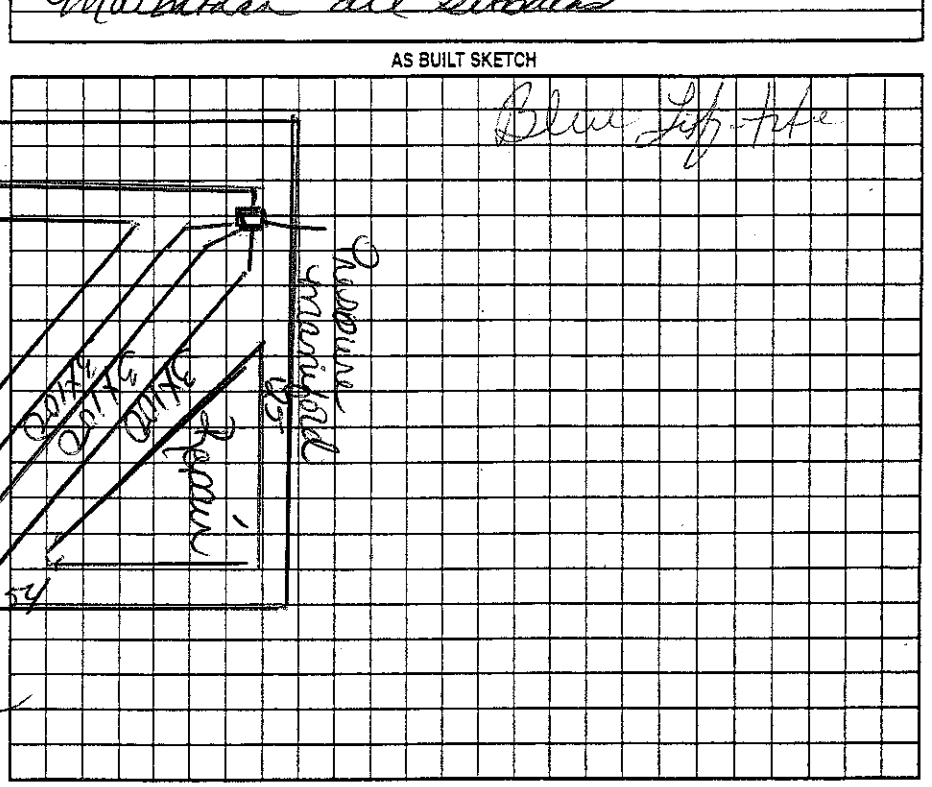

NO Cutting in this area, backfill for positive drainage

Permit can be suspended or revoked if any false information is supplied toward securing the permit/any unauthorized changes are made to the site/any unauthorized changes are made in the installation of the system. Improvement Permit with plat valid without expiration ☐ Improvement Permit with site plan valid for sixty months ☐ Authorization to Construct is valid for a period equal to that of Improvement Permit – not to exceed sixty months.

Signed: [signature] date 2-18-07 Installed by: Rowan Septic

Improvement Permit by: Keith Cook date 4-16-07 Operation Permit by: Keith Cook date 1-30-08

Authorization to Construct by: Keith Cook date 9-24-07 Existing System Inspection by: ___ date ___

HEALTH DEPT. COPY: WHITE OWNER COPY (FINAL): YELLOW OWNER COPY (INITIAL): PINK