IREDELL COUNTY HEALTH DEPARTMENT

Statesville Office (704) 878-5305 | Mooresville Office (704) 660-3625 | PERMIT # 207755

IMPROVEMENT PERMIT / AUTHORIZATION TO CONSTRUCT / OPERATION PERMIT / EXISTING SYSTEM

PIN # 4776629746

APPLICANT: Quint + Donna Streich | APPLICANT ADDRESS: 138 McAllister Rd Statesville NC 28625

SITE ADDRESS: 138 McAllister Rd Statesville NC 28625 | PHONE: 704-902-7645 | ALT. PHONE: N/A

SITE DIRECTIONS: 64 to Swann Rd T/L McAllister 3rd house on right

SUBDIVISION: N/A | SECTION: N/A | LOT # N/A | LOT AREA: 3.79ac | DESIGN FLOW: 360 | L.T.A.R.: 0.3

Septic Tank: Existing (gal) | STB | Date
Pump Tank (gal) | PT | Date
Pump Make | Model | Serial #
Nitrification Fields: 1 | # Lines: 4 | Linear Ft: 304'
Trench Width: 36" | Max. Trench Bottom Depth: 24" | Gravel Depth: N/A


☐ New System ☒ Repair ☐ Expansion | System Type: I II ☒ III IV V VI
System Description: 25% Reduction
Repair System Description:
Maintenance Agreement Required: ☐ YES ☒ NO
☒ GRAVITY ☐ PRESSURE

☒ Residence | No. Bedrooms: 3
☐ Business | No. Persons: 6
☐ Other | No. Employees:
☐ Slab ☒ Crawl Space
☐ Basement w/plumbing ☐ Basement w/o plumbing


Water Supply: ☐ Private ☒ Public ☐ Community

Comments / Conditions: Install 25% reduction on contour with Serial distribution. Check tank, check tee, replace if needed

INITIAL SITE SKETCH

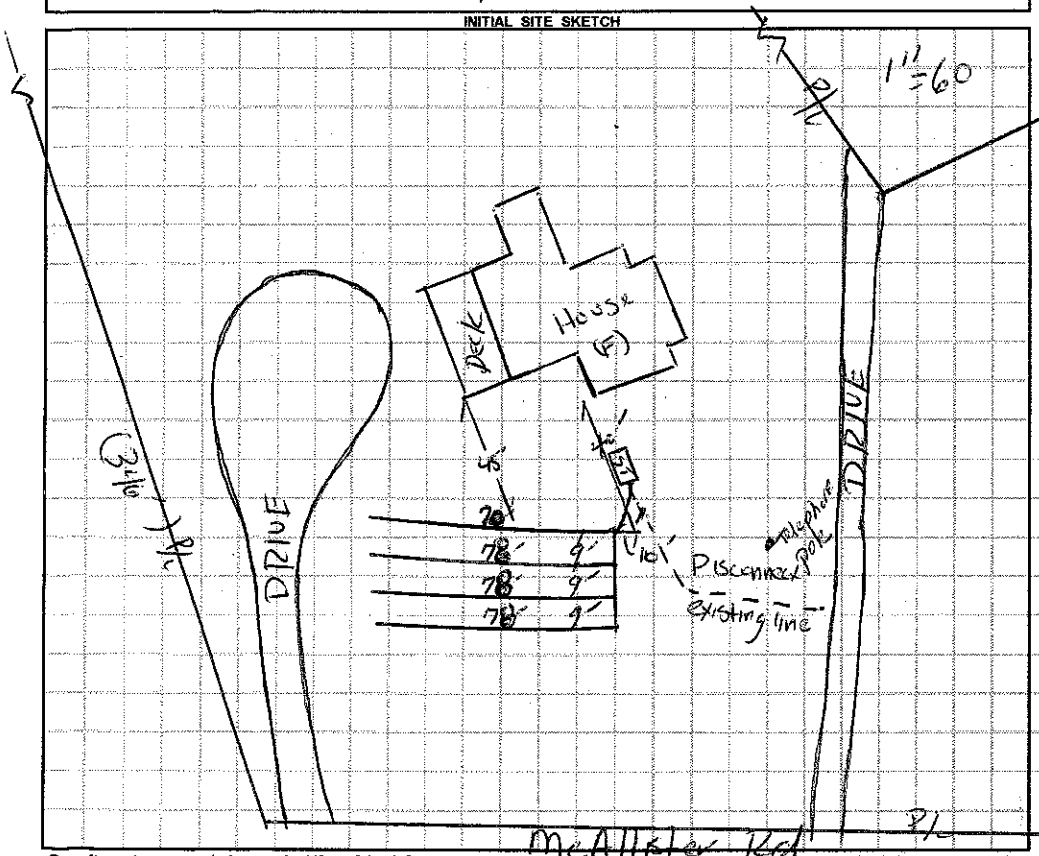

AS BUILT SKETCH

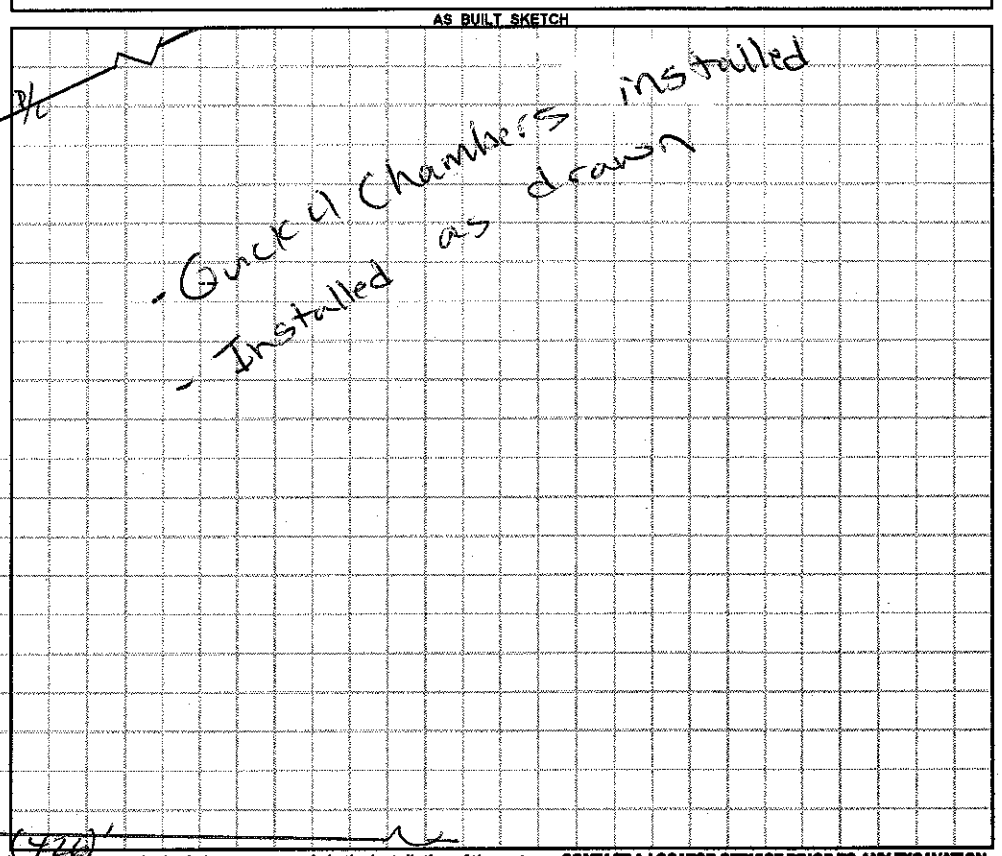

Permit can be suspended or revoked if any false information is supplied toward securing the permit / any unauthorized changes are made to the site / any unauthorized changes are made in the installation of the system. **CONTACT A LOCATOR SERVICE PRIOR TO ANY EXCAVATION**

☐ **IMPROVEMENT PERMIT** *with plat valid without expiration.* ☒ **IMPROVEMENT PERMIT** *with site plan valid for 60 mos.* ☒ **AUTHORIZATION TO CONSTRUCT** *valid for period equal to IMPROVEMENT PERMIT--not to exceed 60 mo.*

Owner / Applicant Signature: Donna Streich | Date: | Installed by: A1 Backhoe

IMPROVEMENT PERMIT by: Dent A Ivey | Date: 01/09/15 | OPERATION PERMIT by: Justin Henderson | Date: 3-13-15

AUTHORIZATION TO CONSTRUCT by: Dent A Ivey | Date: 01/09/15 | Existing System Inspected by: | Date:

Health Dept. Copy - WHITE Applicant (Final Approval) - YELLOW Applicant (Conditional Approval) - PINK