2:00

IREDELL COUNTY HEALTH DEPARTMENT

STATESVILLE 704-878-5305 MOORESVILLE 704-664-5281

IMPROVEMENT PERMIT / AUTHORIZATION TO CONSTRUCT / OPERATION PERMIT / EXISTING SYSTEM INSPECTION

PERMIT# 97482 PIN# 4776 62 8160 DATE 11-4-98

OWNER OR CONTRACTOR Barbara Patronski PHONE: Business _____ Home _____

ADDRESS PO Box 632 sta N.C.

LOCATION 64E Th Swann Rd before McAllister Th Swann Crossing L. on L

SUBDIVISION Swann Crossing BLOCK / SECTION _____ LOT 31 LOT AREA 34000 SITE CLASS. PS DESIGN FLOW 480 L.T.A.R. 1.3

Septic Tank: 1000 Gallons; STB 1012 Date 11-8-98

Pump Tank: _____ Gallons; PT _____ Date _____

Pump Make: _____ Model _____ Serial No. _____

Nitrification Field: No Fields 1 Square Feet 1200 Linear Feet 400

No Lines 4 Trench Width 36" Max Trench Bottom Depth 36" Gravel Depth NA

☒ New System ☐ Repair System Type: I, II, III, IV, V, VI

System Description: Conventional 2 Line

Repair System Description: Pump To "

Maintenance Agreement Required: ☐ Yes ☒ No

☐ House/Mod. Home No. Bedrooms 4

☐ Mobile Home No. Bathrooms 2

☐ Business No. Employees _____

☐ Other _____


☐ Slab ☐ Crawl Space ☐ Basement w/plumbing ☐ Basement wo/plumbing

Water Supply: ☐ Individual ☒ Public ☐ Community


Comments:/Conditions:

Comments:/Conditions:

INITIAL SITE SKETCH

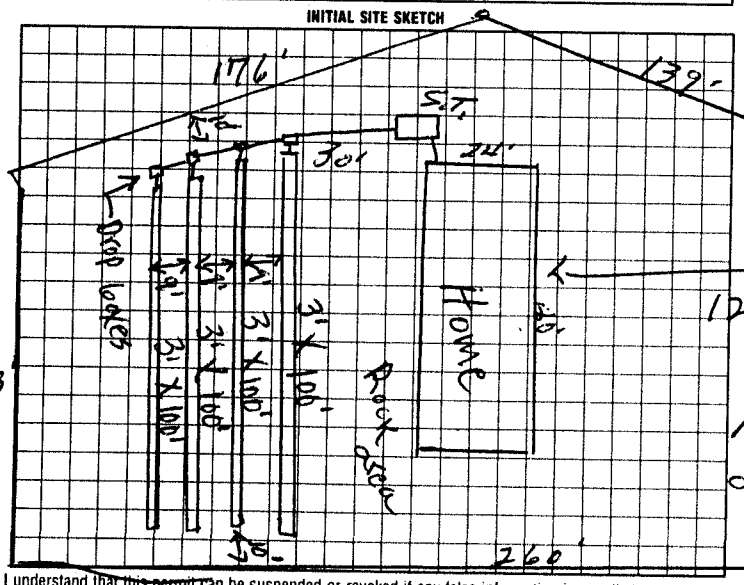

AS BUILT SKETCH

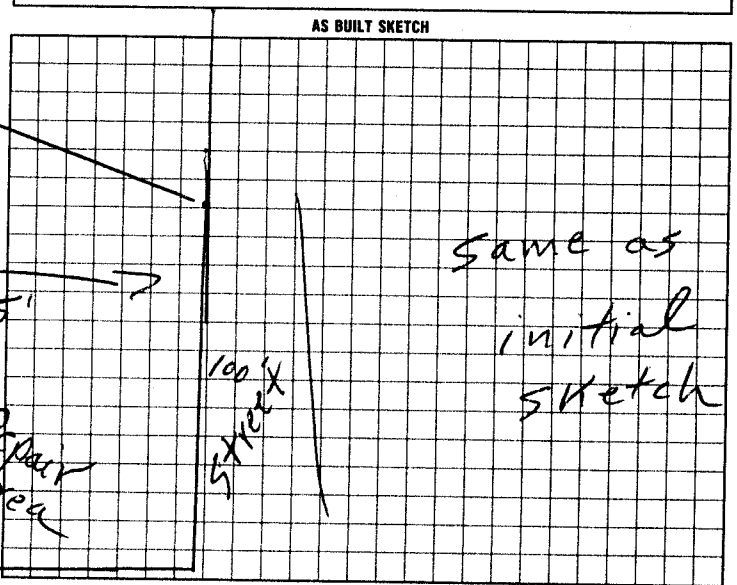

I understand that this permit can be suspended or revoked if any false information is supplied toward securing the permit/any unauthorized changes are made to the site/any unauthorized changes are made in the installation of the system. Improvement Permit with plat valid without expiration. Improvement Permit with site plan valid for sixty months. Authorization to Construct is valid for a period equal to that of Improvement Permit – not to exceed sixty months.

Signed: R. M. Wooten date 11-20-98 Installed by: mike wooten

Improvement Permit by: E.C. Moore date 11-4-98 Operation Permit by: E.C. Moore date 1-29-99

Authorization to Construct by: E.C. Moore date 11-4-98 Existing System Inspection by: _____ date _____

HEALTH DEPT. COPY: WHITE INSPECTION COPY (FINAL) GREEN OWNER COPY (FINAL) YELLOW INSPECTION COPY (INITIAL) PINK OWNER COPY (INITIAL) GOLD