IREDELL COUNTY HEALTH DEPARTMENT

THIS REPLACES PREVIOUS ISSUED 1-6-07 by Mpinto

STATESVILLE 704-878-5305 MOORESVILLE 704-664-5281

IMPROVEMENT PERMIT / AUTHORIZATION TO CONSTRUCT / OPERATION PERMIT / EXISTING SYSTEM INSPECTION

PERMIT # 139763 PIN # 4776-72-2010 DATE 8-9-10

OWNER or APPLICANT Meredith Homes PHONE: Business 704 264 5081 Home:

OWNER or APPLICANT ADDRESS 136 Swann Crossing Drive

LOCATION / DIRECTIONS US 64 East, TL Swann Road, TL Swann Crossing Drive, 5th lot on Right

SUBDIVISION Swann Crossing BLOCK / SECTION III LOT # 13 LOT AREA .535 DESIGN FLOW 360 L.T.A.R. .25

Septic Tank 1000 Gallons: STB 760 Date 5-17-10

Pump Tank 1000 Gallons: P T 360 Date 5-25-10

Pump Make Zoeller Model BN151-B Serial # 151-0005

Nitrification Field No Fields 1 No Lines 3 Linear Feet 360

Trench Width 3 Max. Trench Bottom Depth 36" Gravel Depth n/a ☐ GRAVITY ☒ PRESSURE

☒ New System ☐ Repair ☐ Expansion System Type I II III IV V VI

System Description: 25% Reduction Pump

Repair System Description: 50% Reduction Pump

Maintenance Agreement Required ☐ YES ☒ NO


☒ Residence No. Bedrooms 3 ☐ Business No. Persons ☐ Other No. Employees ☒ Slab ☐ Crawl Space ☐ Basement w/plumbing ☐ Basement w/o plumbing

Water Supply: ☐ Private ☒ Public ☐ Community

Comments / Conditions

Comments / Conditions Poly Lock Filter Fee

INITIAL SITE SKETCH

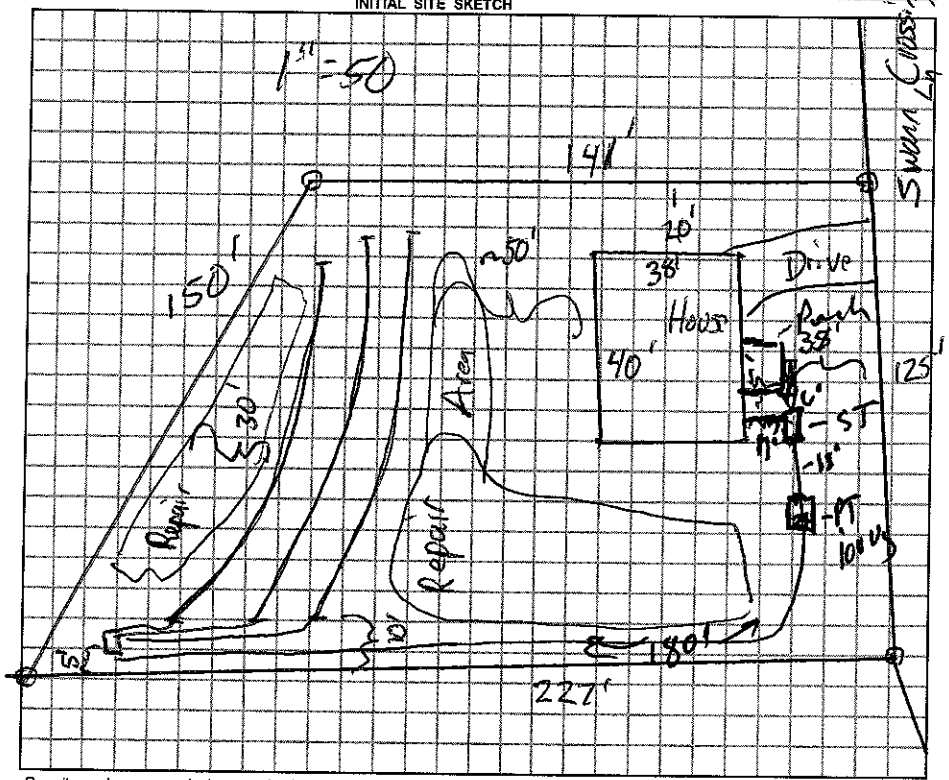

AS BUILT SKETCH

Permit can be suspended or revoked if any false information is supplied toward securing the permit / any unauthorized changes are made to the site / any unauthorized changes are made in the installation of the system.

☐ *IMPROVEMENT PERMIT w / plat valid without expiration.* ☒ *IMPROVEMENT PERMIT w / site plan valid for 60 mos.* ☒ *AUTHORIZATION TO CONSTRUCT valid for period equal to IMPROVEMENT PERMIT-not to exceed 60 mo.*

Owner / Applicant Signature: Date 8-9-10

Improvement Permit by: Date 8-9-10

Authorization to Construct by: Date 8-9-10

YOU SHOULD CONTACT A LOCATOR SERVICE PRIOR TO ANY EXCAVATION.

Installed by: TIM Abegg

Operation Permit by: Date: 11-12-10

Existing System Inspected by: Date:

WHITE COPY Environmental Health YELLOW COPY (Final) Owner / Applicant PINK COPY (Initial) Owner / Applicant