IREDELL COUNTY HEALTH DEPARTMENT

Statesville Phone TR 3-7271 Mooresville Phone NO 3-1271

PERMIT TO INSTALL SEPTIC TANK

Permit No. _____ Permit Date Oct 10 1968

Owner M.P. Knox Address R4

Installed By C Hoke Address R7


Location of Property out 64 E. left paved Rd before Sta. test farm. on R split level 1 mile

Tank		Capacity		Length of Lines		Fixtures	
Block	( )	1000	( )	225'	( )	No. of Baths	(2½)
Precast	(✓)	1250	(✓)	250'	( )	Dishwasher	(✓)
		1500	( )	Other 255		Garbage Grdr.	(✓)
		Other _____				Other _____	

NOTIFY HEALTH DEPARTMENT AT LEAST EIGHT HOURS BEFORE TANK IS TO BE INSPECTED.

Final Inspection _____ 19___ Approved (✓) Disapproved ( )

Remarks County water supply. Wooded - Hard subsoil.

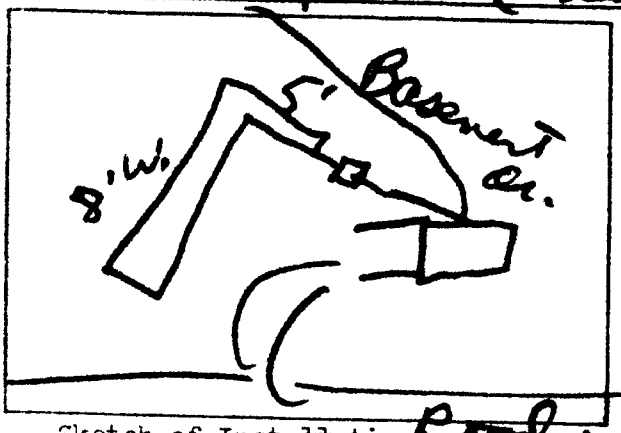

Sketch of Installation Level

Sanitarian