IREDELL COUNTY HEALTH DEPARTMENT - *ENVIRONMENTAL HEALTH* ☒ STATESVILLE OFFICE 704-878-5305 ☐ MOORESVILLE OFFICE 704-664-5281

IMPROVEMENT PERMIT / AUTHORIZATION TO CONSTRUCT (I) / OPERATION PERMIT (O) / EXISTING SYSTEM INSPECTION

PERMIT # 163646 PIN # 4776-74-3122 DATE 11-3-10

OWNER Marty Newton Haseline APPLICANT: Morefield Builders PHONE: Home/Cell # 704 873 7885 Business #

SITE ADDRESS 352 Swann Rd. OWNER / APPLICANT ADDRESS 352 Swann Rd

SITE DIRECTIONS 64E, left on Swann Rd on (R)

SUBDIVISION n/a BLOCK / SECTION n/a LOT # n/a LOT AREA .76 DESIGN FLOW 480 L.T.A.R. .3

Septic Tank 1000 Gallons: STB Date

Pump Tank Gallons: P T Date

Pump Make Model Serial #

No. Nitrification Fields: 1 No. Lines (2 add) 6 total Linear Feet 400 total (100 add)

Trench Width 36" Max. Trench Bottom Depth 36"

☐ New System ☐ Repair ☒ Expansion System Type I II (III) IV V VI

System Description: 25% Reduction Gravity

Repair System Description: 25% Reduction (Pump if necessary)

Maintenance Agreement Required ☐ YES ☒ NO

Gravel Depth ☒ GRAVITY ☐ PRESSURE

☒ Residence No. Bedrooms 4

☐ Business No. Persons

☐ Other No. Employees

☐ Slab ☒ Crawl Space

☐ Basement w/plumbing ☐ Basement w/o plumbing

Water Supply


☐ Private

☒ Public


☐ Community

Comments / Conditions: Add 100' of 25% Reduction

INITIAL SITE SKETCH

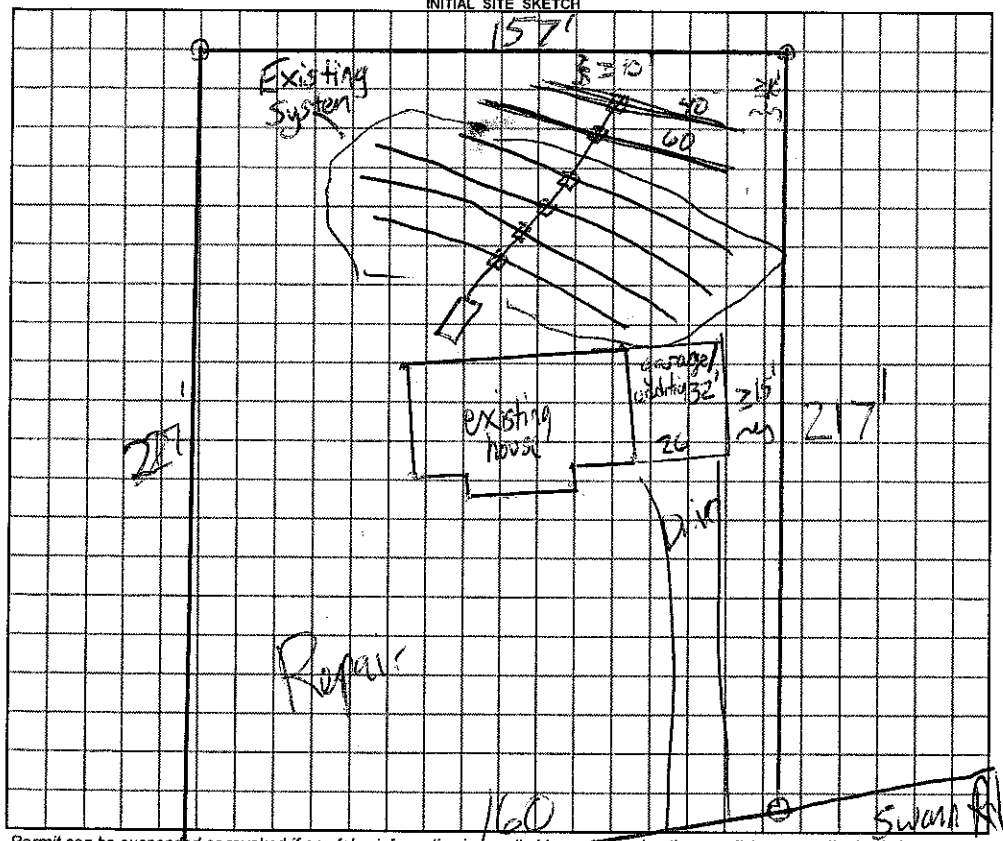

AS BUILT SKETCH

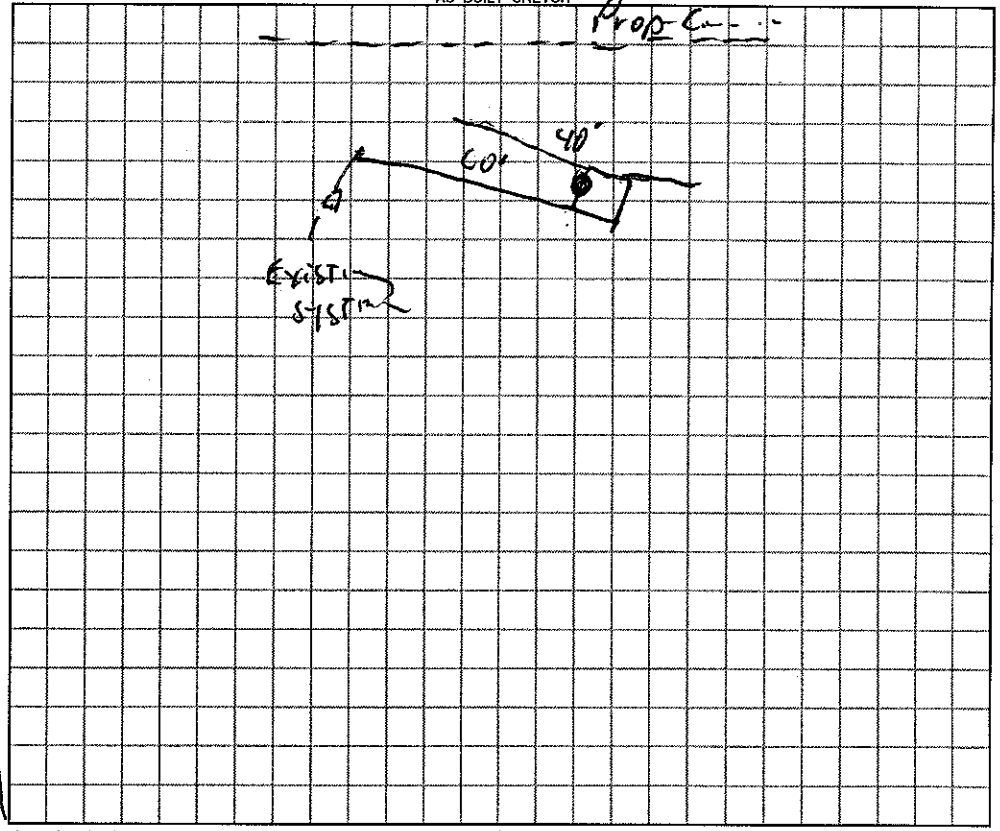

Permit can be suspended or revoked if any false information is supplied toward securing the permit / any unauthorized changes are made to the site / any unauthorized changes are made in the installation of the system.

☐ ***IMPROVEMENT PERMIT*** with plat valid without expiration. ☐ ***IMPROVEMENT PERMIT*** with plat valid without expiration. ☐ ***AUTHORIZATION TO CONSTRUCT*** valid for period equal to IMPROVEMENT PERMIT--not to exceed 60 mo.

Owner / Applicant Signature: Date 11-8-10 Installed by: Steve Jordan

IMPROVEMENT PERMIT by: REHS Date 11-5-10 OPERATION PERMIT by: R.S. REHS Date 15 Feb. 11

AUTHORIZATION TO CONSTRUCT by: REHS Date 11-5-10 Existing System Inspected by: REHS Date

YOU SHOULD CONTACT A LOCATOR SERVICE PRIOR TO ANY EXCAVATION

White Copy – Environmental Health YELLOW COPY (Final) Owner / Applicant PINK COPY (Initial) Owner / Applicant