IREDELL COUNTY HEALTH DEPARTMENT

STATESVILLE 704-878-5305 MOORESVILLE 704-664-5281

IMPROVEMENT PERMIT / AUTHORIZATION TO CONSTRUCT / OPERATION PERMIT / EXISTING SYSTEM INSPECTION

PERMIT# 135098 PIN# 4776870591 DATE 5-9-06

OWNER OR APPLICANT Lennar NC PHONE: Business 704 873-3006 Home

ADDRESS 112 Island Ford Statesville NC

LOCATION 64E to Swan Rd Property on Right

SUBDIVISION Sage Forest BLOCK / SECTION I LOT 1 LOT AREA .57 SITE CLASS: B DESIGN FLOW 360 L.T.A.R. .3

Septic Tank: 1000 Gallons; STB 1007 Date 7-5-06
Pump Tank: Gallons; PT Date
Pump Make: Model Serial No.
Nitrification Field: No Fields Square Feet 1200 Linear Feet 300
No Lines 4 Trench Width 12" Max Trench Bottom Depth 36 Gravel Depth

☑ New System ☐ Repair ☐ Expansion System Type: I II III IV V VI
System Description: 25% Conv
Repair System Description:
Maintenance Agreement Required: ☐ Yes ☐ No

☑ House/Mod. Home No. Bedrooms 3
☐ Mobile Home No. Persons
☐ Business No. Employees
☐ Other


Water Supply: ☐ Individual ☑ Public ☐ Community

☑ Gravity ☐ Pressure ☐ Slab ☐ Crawl Space ☐ Basement w/plumbing ☐ Basement wo/plumbing


Comments:/Conditions:
Install on Contour
Maintain all setbacks

Comments:/Conditions:
Grey Lattey Letter
Septic tank marker

INITIAL SITE SKETCH

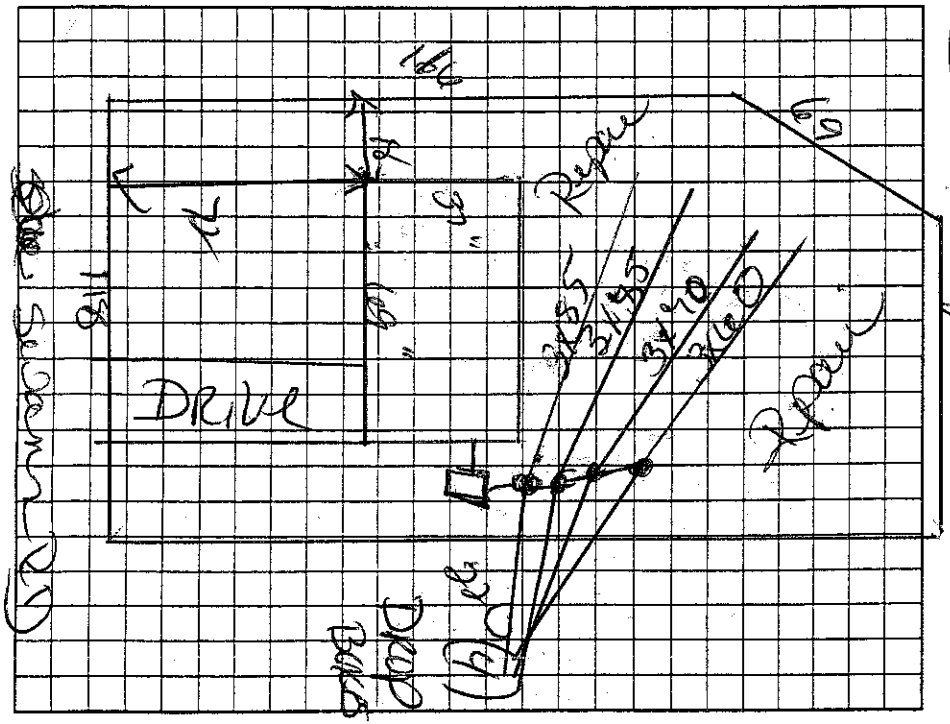

AS BUILT SKETCH

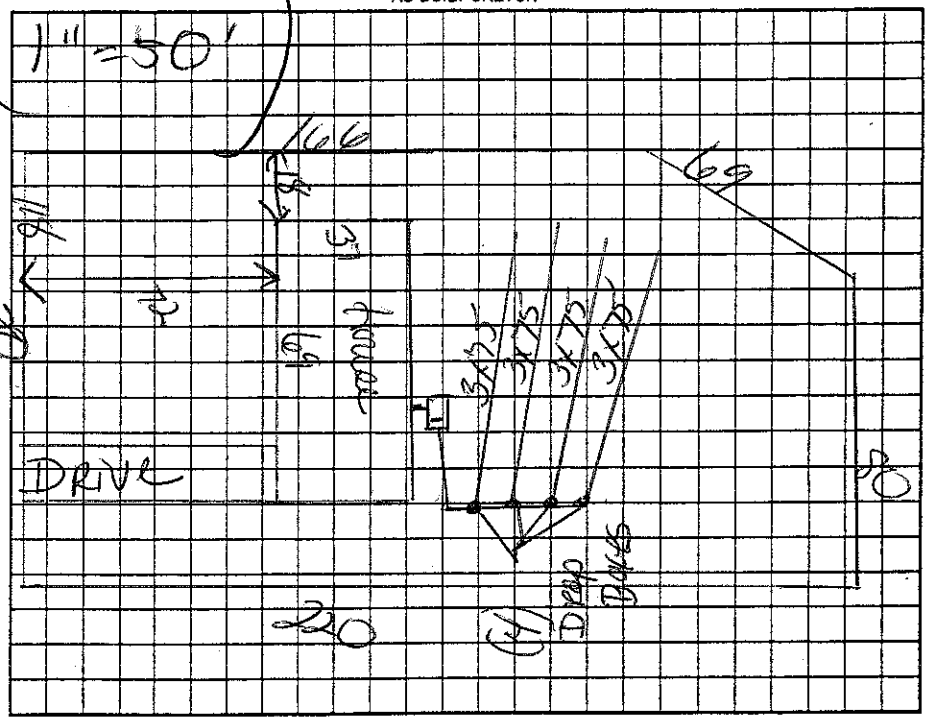

Permit can be suspended or revoked if any false information is supplied toward securing the permit/any unauthorized changes are made to the site/any unauthorized changes are made in the installation of the system. Improvement Permit with plat valid without expiration. ☐ Improvement Permit with site plan valid for sixty months ☐ Authorization to Construct is valid for a period equal to that of Improvement Permit – not to exceed sixty months.

Signed Bruce Pora date

Improvement Permit by: Kelly Cook date 5-9-06

Authorization to Construct by: Kelly Cook date 5-9-06

Installed by: Tommy Cothren

Operation Permit by: Kelly Cook date 8-15-06

Existing System Inspection by: date

HEALTH DEPT. COPY: WHITE OWNER COPY (FINAL): YELLOW OWNER COPY (INITIAL): PINK