IREDELL COUNTY HEALTH DEPARTMENT

STATESVILLE 704-878-5305 MOORESVILLE 704-664-5281

IMPROVEMENT PERMIT / AUTHORIZATION TO CONSTRUCT / OPERATION PERMIT / EXISTING SYSTEM INSPECTION

PERMIT# 146558 PIN# 4797681509 0817 DATE 12-11-07

OWNER OR APPLICANT Bruce Porter PHONE: Business Home

ADDRESS 2143 Rockwell Hwy Statesville NC 28625

LOCATION Lft E (D) Swann Rd (D) Sagefield Dr. Cactus Rt Bluff Ct

SUBDIVISION Sagefield BLOCK / SECTION 2 LOT 16 LOT AREA .827 SITE CLASS: RS DESIGN FLOW 360 L.T.A.R. .3 Repair .25

Septic Tank: 1000 Gallons; STB Date

Pump Tank: Gallons; PT Date

Pump Make: Model Serial No.

Nitrification Field: No Fields Square Feet 1200 Linear Feet 300

No Lines 4 Trench Width 36" Max Trench Bottom Depth 24" Gravel Depth NR

☑ New System ☐ Repair ☐ Expansion System Type: I II III IV V VI

System Description: 25% Graduate

Repair System Description: 25% Graduate / Pump

Maintenance Agreement Required: ☐ Yes ☐ No

☑ House/Mod. Home ☐ Mobile Home ☐ Business ☐ Other

No. Bedrooms 3 No. Persons 2 No. Employees

Water Supply: ☐ Individual ☑ Public ☐ Community


☐ Gravity ☐ Pressure ☐ Slab ☑ Crawl Space ☐ Basement w/plumbing ☐ Basement wo/plumbing

Comments:/Conditions:


Comments:/Conditions:

Install on Contour
Maintain all setbacks

INITIAL SITE SKETCH

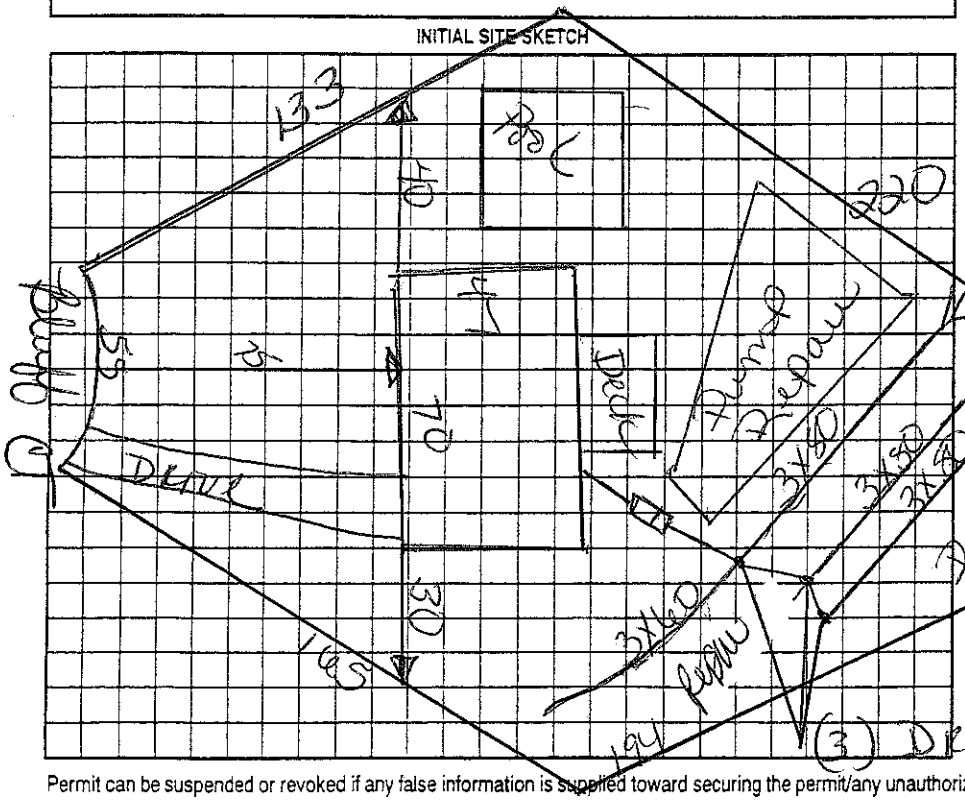

AS BUILT SKETCH

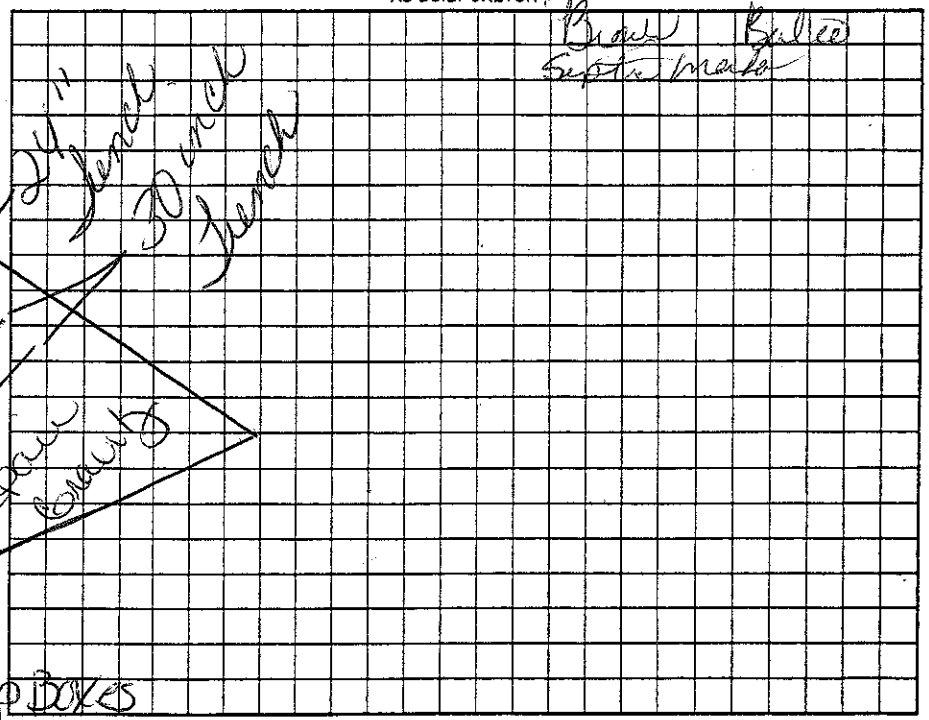

Permit can be suspended or revoked if any false information is supplied toward securing the permit/any unauthorized changes are made to the site/any unauthorized changes are made in the installation of the system. Improvement Permit with plat valid without expiration ☐ Improvement Permit with site plan valid for sixty months ☐ Authorization to Construct is valid for a period equal to that of Improvement Permit – not to exceed sixty months.

Signed: Bruce Porter date

Improvement Permit by: Kelly Cook date 12-11-07

Authorization to Construct by: Kelly Cook date 12-11-07

Installed by: Tommy Cook

Operation Permit by: Kelly Cook date 7-4-08

Existing System Inspection by: date

HEALTH DEPT. COPY: WHITE OWNER COPY (FINAL): YELLOW OWNER COPY (INITIAL): PINK