WINDOW SCHEDULE

MARK	ROUGH OPN'G	DESCRIPTION	PELLA NO.	QUAN.
A	4'-2 1/2" x 3'-6"	CASEMENT	DOUGH 2041-2	1
B	5'-6" x 4'-3 1/4"	DOUBLE HUNG	DOUGH 3015-2	1
C	5'-6" DIAMETER	CIRCLEHEAD	SPECIAL	1
D	5'-6" x 5'-3 1/4"	DOUBLE HUNG	DOUGH 3363-2	3
E	2'-5 1/4" x 5'-3 1/4"	DOUBLE HUNG	DOUGH 3363	5

ALL WINDOWS ARE INSULATED AND WEATHERSTRIPPED AS MANUFACTURED BY "PELLA" (ROLLSCREEN CO. PELLA, IOWA 50219)

VERIFY LOCAL CODE EGRESS WINDOW REQUIREMENTS PRIOR TO CONSTRUCTION


VERIFY WINDOW MODEL NUMBERS AND SIZES WITH MANUFACTURER BEFORE STARTING CONSTRUCTION

DOOR SCHEDULE

MARK	SIZE	DESCRIPTION	QUAN.
1	3'-0" x 8'-0" x 1 3/4"	EXT. HARDWOOD w/ 12" SIDELIGHT	1
2	2'-6" x 6'-8" x 1 3/8"	INT. HARDWOOD	2
3	5'-0" x 6'-8" x 1 3/8"	INT. BI-FOLD	2
4	2'-4" x 6'-8" x 1 3/8"	INT. HARDWOOD	2
5	2'-8" x 6'-8" x 1 3/8"	INT. HARDWOOD	1
6	12'-0" x 6'-8" x 1 3/8"	INT. HARDWOOD	1
7	2'-6" x 6'-8" x 1 3/8"	INT. HARDWOOD	1
8	2'-8" x 6'-8" x 1 3/8"	INT. POCKET	1
9	2'-8" x 6'-8" x 1 3/4"	EXT. HARDWOOD - FRENCH	1
10	2'-8" x 6'-8" x 1 3/4"	EXT. HARDWOOD - 1 HOUR RATED	1
11	16'-0" x 7'-0"	GARAGE	1
12	2'-6" x 6'-8" x 1 3/8"	INT. BI-FOLD	1

ELECTRICAL LEGEND

SYMBOL	DESCRIPTION
	DUPLEX OUTLET (GROUNDED TYPE)
	WEATHER PROOF DUPLEX OUTLET
	WALL SWITCH CONTROLLED DUPLEX OUTLET
	ABOVE COUNTER LOCATION
	FLUSH FLOOR WALL SWITCH CONTROLLED DUPLEX OUTLET, OWNER VERIFY LOCATION
	220 VOLT OUTLET OR CONNECTION
	TELEVISION ANTENNA / CABLE OUTLET
	TELEPHONE OUTLET LOCATION
	DOOR CHIME LOCATION
	110 VOLT JUNCTION BOX
	SINGLE POLE WALL SWITCH
	SINGLE POLE WALL SWITCH WITH DIMMER
	3-WAY WALL SWITCH
	3-WAY WALL SWITCH WITH DIMMER
	CEILING MOUNTED LIGHT FIXTURE
	WALL BRACKET MOUNTED LIGHT FIXTURE
	SUSPENDED CEILING MOUNTED LIGHT FIXTURE
	RECESSED DIRECTIONAL CEILING LIGHT FIXTURE
	RECESSED CEILING LIGHT FIXTURE
	RECESSED LIGHT FOR WET AREA
	ONE TUBE UNDER COUNTER FLUORESCENT LIGHT
	EXTERIOR CAST ALUMINUM FLOOD LIGHTS
	CEILING MOUNTED FAN - PADDLE
	CEILING MOUNTED FAN - EXHAUST
	CEILING MOUNTED FAN AND HEATER
	PORCELAIN LAMPHOLDER
	DOOR BELL BUTTON
	SMOKE DETECTOR
	CEILING MOUNTED FAN, LIGHT, AND HEATER

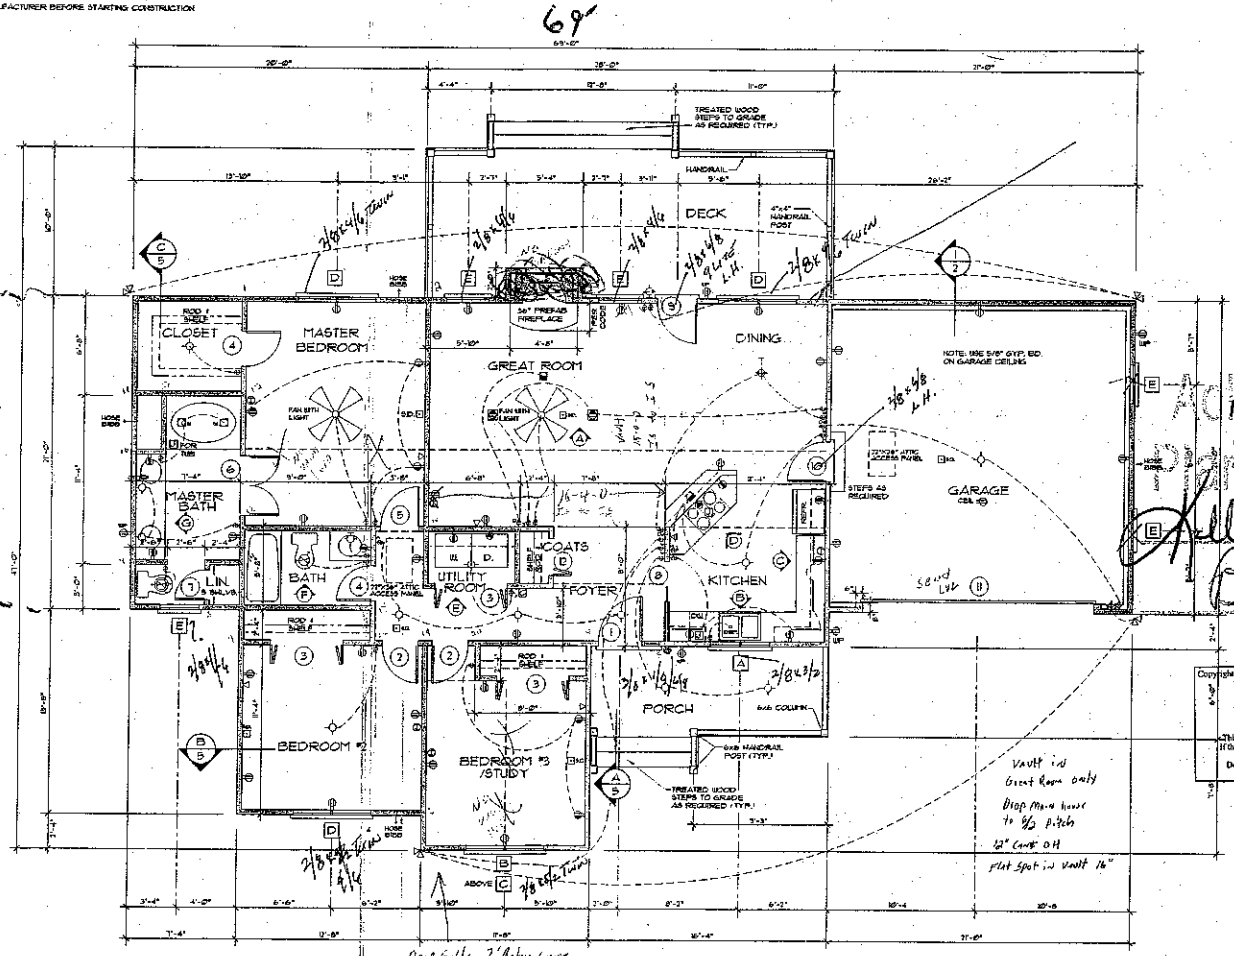

FLOOR PLAN

1/4" = 1'-0"

TOTAL LIVING ——— 1471 sq. ft.
GARAGE & STORAGE ——— 448 sq. ft.

Acknowledgement
DRB Submittal ONLY
Date 12-1107
Bruce Porter Date 1

Copyrighted by Donald A. Gardner Architects, Inc and/or Donald A. Gardner, Inc

REG.#

This stamp must appear in RED INK. If this stamp is not in red ink, then it is illegal copy. Return the illegal copy to Donald A. Gardner, Architects, Inc 1-800-368-7580

RED INK.

NOTE:
VERIFY ALL LOCAL CODES, ENERGY TYPES AND SITE CONDITIONS PRIOR TO CONSTRUCTION. REVIEW SELECTED MECHANICAL SYSTEMS WITH OWNER PRIOR TO CONSTRUCTION. RECOMMENDED LOCATIONS ARE AS FOLLOWS: THE WATER HEATER MAY TYPICALLY BE PLACED IN THE CRAWL SPACE OR IN THE GARAGE. H.V.A.C. UNIT MAY TYPICALLY BE PLACED IN THE CRAWL SPACE OR ATTIC SPACE. H.V.A.C. EQUIPMENT IN ATTIC SPACE SHALL BE ACCESSIBLE BY AN OPENING AS LARGE AS THE LARGEST PIECE OF EQUIPMENT AND IN NO CASE LESS THAN 22"X36".

SEE STRUCTURAL DRAWINGS FOR ADDITIONAL INFORMATION.

INSULATE AROUND ALL BATHS AND UTILITY ROOM.

TYPICAL WALL 2"x4" @ 16" O.C. UNLESS OTHERWISE DIMENSIONED

ALL FEDERAL, STATE, AND LOCAL CODES, ORDINANCES, REGULATIONS ETC. SHALL BE CONSIDERED AS PART OF SPECIFICATIONS FOR THIS BUILDING AND SHALL TAKE PRECEDENCE OVER ANYTHING SHOWN, DESCRIBED, OR IMPLIED WHERE SAME ARE AT VARIANCE

DONALD A. GARDNER
ARCHITECTS, INC.
P.O. BOX 26178 • GREENSBORO, N.C. • 27416
884 • 288 • 7560
www.dongardner.com

DESIGN NO. 43-HR
SHEET 2 OF 6
FLOOR PLAN

DO NOT SCALE DRAWINGS.
COPYRIGHT © 10/6/95 ALL RIGHTS RESERVED BY DONALD A. GARDNER, ARCHITECT, INC. NOT TO BE COPIED OR REPRODUCED WITHOUT WRITTEN PERMISSION