CI

IREDELL COUNTY HEALTH DEPARTMENT

STATESVILLE 704-878-5305 MOORESVILLE 704-664-5281

IMPROVEMENT PERMIT / AUTHORIZATION TO CONSTRUCT / OPERATION PERMIT / EXISTING SYSTEM INSPECTION

PERMIT# 132486 PIN# ~~4776814531.002~~ / 4776-81-1432 DATE 12-15-05

OWNER OR CONTRACTOR WCU Inc. PHONE: Business 704 873 2006 Home 704 902 6888

ADDRESS Swann Rd.

LOCATION Hwy 64 E TL Swann Rd - go ~3/4 mile on right

SUBDIVISION Sage Forest BLOCK / SECTION I LOT 2 LOT AREA .512 SITE CLASS. PS DESIGN FLOW 360 L.T.A.R. .3

Septic Tank: 1000 Gallons; STB 1007 Date 10-06

Pump Tank: ____ Gallons; PT ____ Date ____

Pump Make: ____ Model ____ Serial No. ____

Nitrification Field: No Fields 1 Square Feet 1200 Linear Feet 300

No Lines 4 Trench Width 3' Max Trench Bottom Depth 36" Gravel Depth ____

☒ New System ☐ Repair System Type: I (II) III IV V VI

System Description: 25% Reduction - Gravity

Repair System Description: 50% Reduction - Pump

Maintenance Agreement Required: ☐ Yes ☒ No

☒ House/Mod. Home ☐ Mobile Home ☐ Business ☐ Other

No. Bedrooms 3 No. Bathrooms ____ No. Employees ____

☐ Slab ☒ Crawl Space ☐ Basement w/plumbing ☐ Basement wo/plumbing


Water Supply: ☐ Individual ☒ Public ☐ Community

Comments:/Conditions:

Comments:/Conditions:

Gray Filter ST mark

INITIAL SITE SKETCH

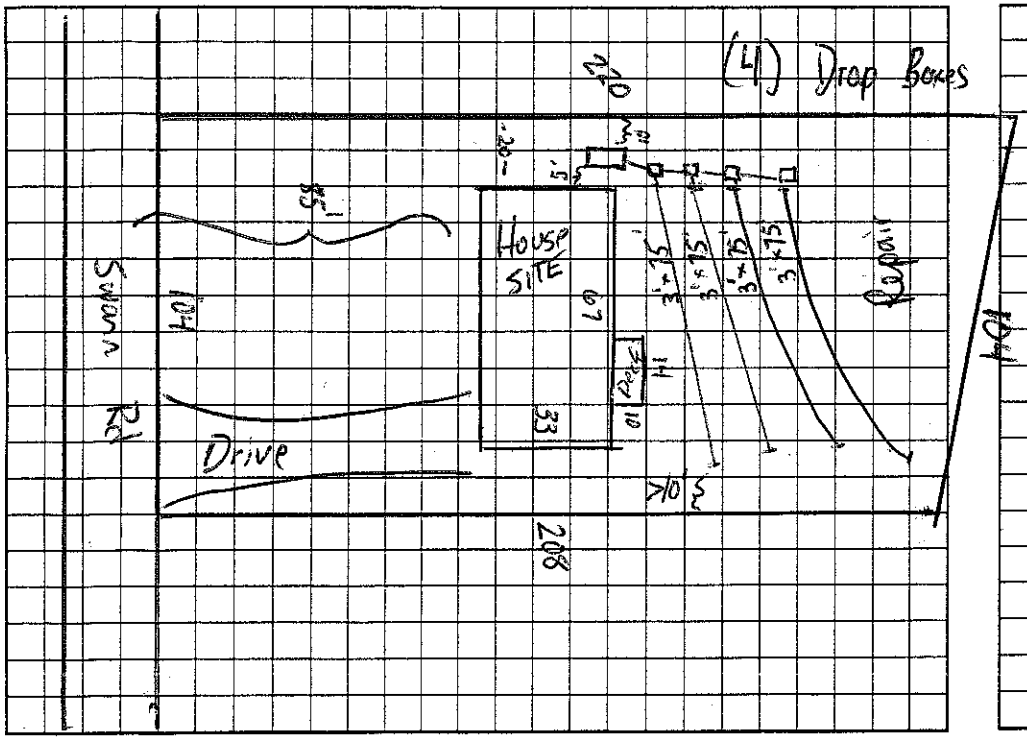

AS BUILT SKETCH

Permit can be suspended or revoked if any false information is supplied toward securing the permit/any unauthorized changes are made to the site/any unauthorized changes are made in the installation of the system. Improvement Permit with plat valid without expiration. Improvement Permit with site plan valid for sixty months. Authorization to Construct is valid for a period equal to that of Improvement Permit – not to exceed sixty months.

Signed: ____ date 12-16-05 Installed by: Cothran & Son

Improvement Permit by: James Stone date 12-15-05 Operation Permit by: James Stone date 3-15-06

Authorization to Construct by: James Stone date 12-15-05 Existing System Inspection by: ____ date ____

HEALTH DEPT. COPY: WHITE OWNER COPY (FINAL): YELLOW OWNER COPY (INITIAL): PINK