IREDELL COUNTY HEALTH DEPARTMENT

STATESVILLE 704-878-5305 MOORESVILLE 704-664-5281

IMPROVEMENT PERMIT / AUTHORIZATION TO CONSTRUCT / OPERATION PERMIT / EXISTING SYSTEM INSPECTION

PERMIT# 134631 PIN# 4776812185 DATE 12-19-06

OWNER OR APPLICANT Bruce Porter PHONE: Business Home

ADDRESS 204 Swann RD Statesville NC 28625

LOCATION 64E to Swann RD, Colonial

SUBDIVISION Sagefield BLOCK / SECTION 1 LOT 4 LOT AREA 1.87 SITE CLASS. RS DESIGN FLOW 360 L.T.A.R. .3

Septic Tank: 1000 Gallons; STB 1012 Date 2-21-07

Pump Tank: Gallons; PT Date

Pump Make: Model Serial No.

Nitrification Field: No Fields Square Feet 1200 Linear Feet 300

No Lines 5 Trench Width 3'-4" Max Trench Bottom Depth 36" Gravel Depth NA ☑ Gravity ☐ Pressure

☐ New System ☐ Repair ☐ Expansion System Type: I II III IV V VI

System Description: 2570 (Paul)

Repair System Description: 2570 Purple

Maintenance Agreement Required: ☐ Yes ☑ No

☑ House/Mod. Home ☐ Mobile Home ☐ Business ☐ Other

No. Bedrooms 3 No. Persons No. Employees

Water Supply: ☐ Individual ☑ Public ☐ Community

☐ Slab ☐ Crawl Space ☐ Basement w/plumbing ☐ Basement wo/plumbing


Comments:/Conditions:

Maintain all setbacks
Install on contour

Comments:/Conditions:

Septic tank marker
Yellow tape to Silver

INITIAL SITE SKETCH

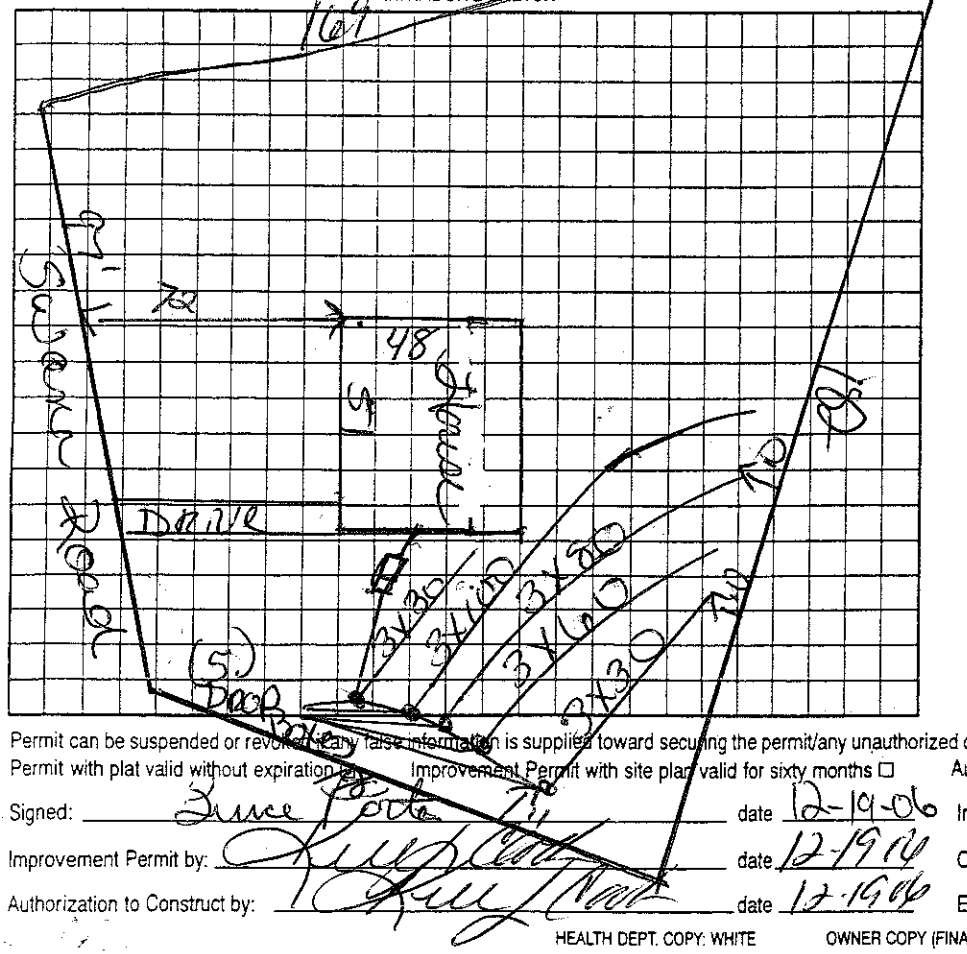

AS BUILT SKETCH

Permit can be suspended or revoked if any false information is supplied toward securing the permit/any unauthorized changes are made to the site/any unauthorized changes are made in the installation of the system. Improvement Permit with plat valid without expiration date ☐ Improvement Permit with site plan valid for sixty months ☐ Authorization to Construct is valid for a period equal to that of Improvement Permit – not to exceed sixty months.

Signed: Bruce Porter date 12-19-06 Installed by: Tommy Cothren

Improvement Permit by: date 12-19-06 Operation Permit by: date 5-30-07

Authorization to Construct by: date 12-19-06 Existing System Inspection by: date

HEALTH DEPT. COPY: WHITE OWNER COPY (FINAL): YELLOW OWNER COPY (INITIAL): PINK