IREDELL COUNTY HEALTH DEPARTMENT - *ENVIRONMENTAL HEALTH* ☑ STATESVILLE OFFICE 704-878-5305 ☐ MOORESVILLE OFFICE 704-664-5281

IMPROVEMENT PERMIT / AUTHORIZATION TO CONSTRUCT / OPERATION PERMIT / EXISTING SYSTEM INSPECTION

PERMIT # 169773 PIN # 4776-81-2680 DATE 30 January 2012

OWNER Bruce Porter APPLICANT: Same PHONE: Home/Cell # (704) 902-3124 Business #

SITE ADDRESS 117 Bluff Ct. Statesville OWNER / APPLICANT ADDRESS

SITE DIRECTIONS Hwy 64 E TL Sawmill Rd. TR Sage Field D. TL Cactus Ln TL Bluff Ct. on left.

SUBDIVISION Sage Forest II BLOCK / SECTION LOT # 18 LOT AREA 10.665 ac. DESIGN FLOW 360 g/d L.T.A.R. 0.3 g/ft²

Septic Tank 1000 Gallons: STB 1000 GST 160 Date 12-15-11

Pump Tank Gallons: P T Date

Pump Make Model Serial #

No. Nitrification Fields: 1 No. Lines 4 Linear Feet 300

Trench Width 36" Max. Trench Bottom Depth 36" Gravel Depth NA

☑ New System ☐ Repair ☐ Expansion System Type I II (III) IV V VI

System Description: 25% Reduction

Repair System Description: 25% Reduction

Maintenance Agreement Required ☐ YES ☑ NO

☑ GRAVITY ☐ PRESSURE

☑ Residence No. Bedrooms 3

☐ Business No. Persons

☐ Other No. Employees


☐ Slab ☑ Crawl Space

☐ Basement w/plumbing ☐ Basement w/o plumbing


Water Supply: ☐ Private ☑ Public ☐ Community

Comments / Conditions * Follow contour / Honor setback requirements

INITIAL SITE SKETCH

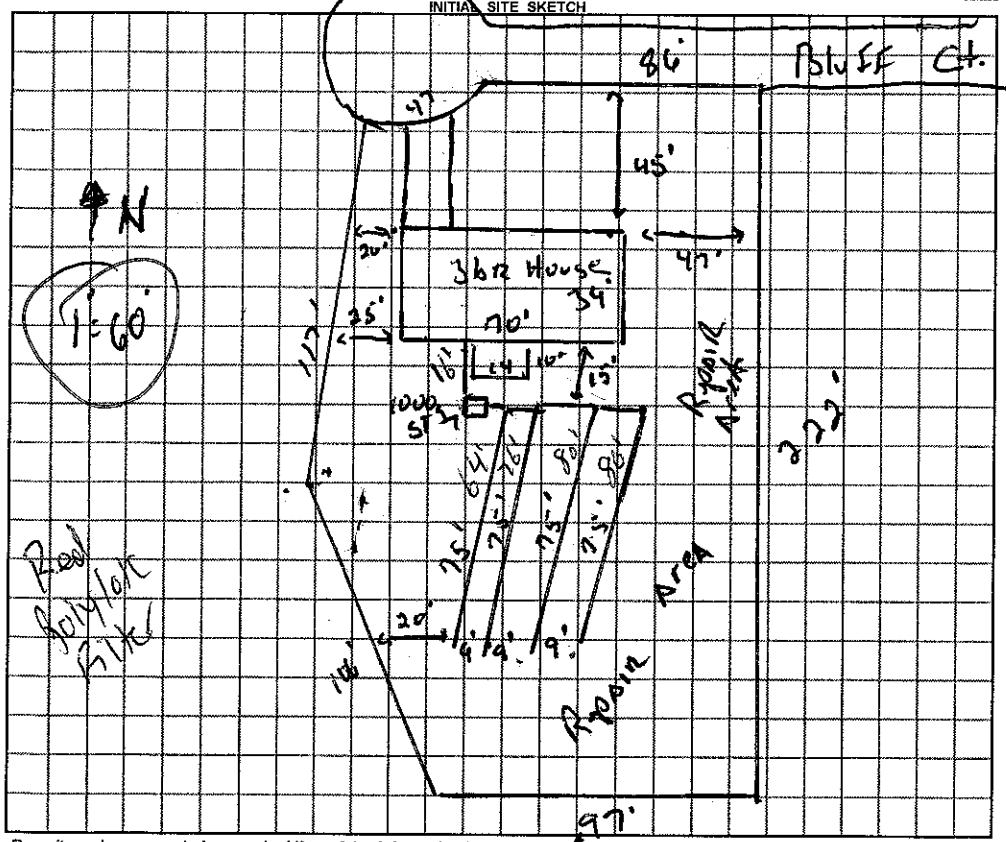

AS BUILT SKETCH

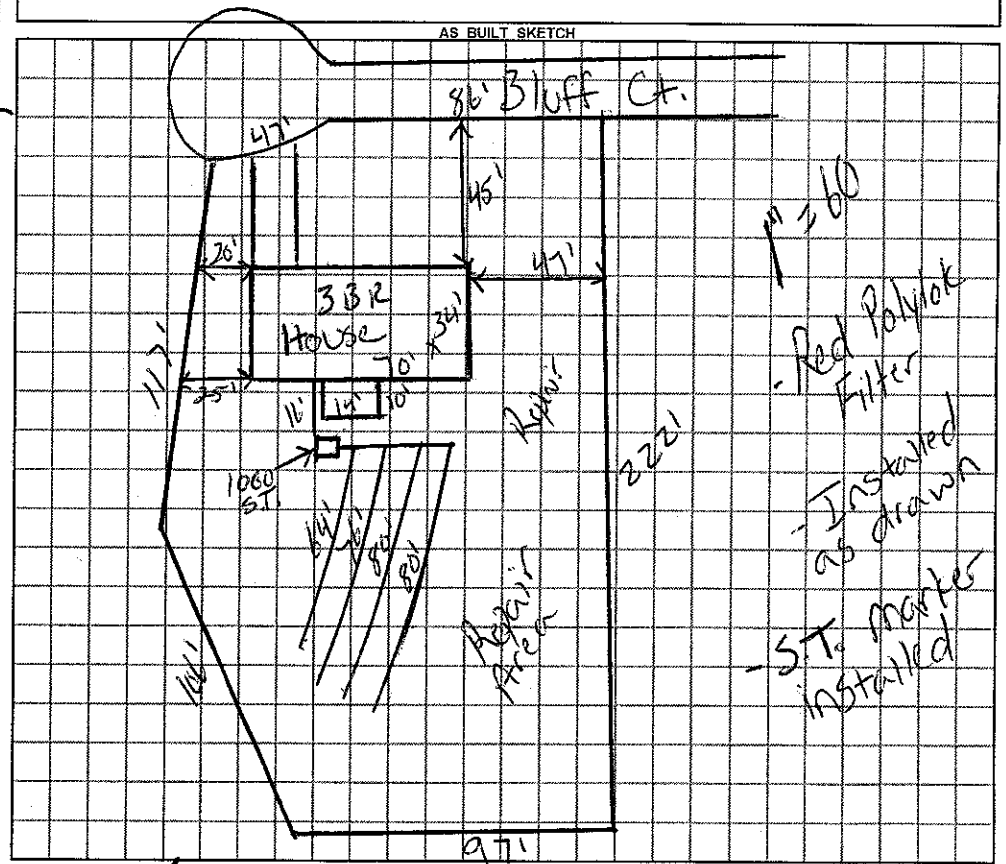

Permit can be suspended or revoked if any false information is supplied toward securing the permit / any unauthorized changes are made to the site / any unauthorized changes are made in the installation of the system.

☐ ***IMPROVEMENT PERMIT*** with plat valid without expiration. ☑ ***IMPROVEMENT PERMIT*** with plat valid without expiration. *site plan valid 60 mo.* ☑ ***AUTHORIZATION TO CONSTRUCT*** valid for period equal to IMPROVEMENT PERMIT--not to exceed 60 mo.

Owner / Applicant Signature: Bruce Porter Date 1-31-12 Installed by: Tommy Cothren

IMPROVEMENT PERMIT by: REHS Date 30 Jan. 12 OPERATION PERMIT by: Justin Hendrix REHS Date 4-30-12

AUTHORIZATION TO CONSTRUCT by: REHS Date 30 Jan. 12 Existing System Inspected by: REHS Date

YOU SHOULD CONTACT A LOCATOR SERVICE PRIOR TO ANY EXCAVATION

White Copy – Environmental Health YELLOW COPY (Final) Owner / Applicant PINK COPY (Initial) Owner / Applicant