IREDELL COUNTY HEALTH DEPARTMENT - *ENVIRONMENTAL HEALTH* ☐ STATESVILLE OFFICE 704-878-5305 (A) ☐ MOORESVILLE OFFICE 704-664-5281 (C)

IMPROVEMENT PERMIT / AUTHORIZATION TO CONSTRUCT / OPERATION PERMIT / EXISTING SYSTEM INSPECTION

PERMIT # 164768 PIN # 4776-81-2865 DATE FEBRUARY 8, 2011

OWNER BRUCE PORTER APPLICANT: PHONE: Home/Cell # 704-902-3124 Business # 704-878-9314

SITE ADDRESS 118 BLUFF COURT OWNER / APPLICANT ADDRESS

SITE DIRECTIONS US 64 E, TL SWANN RD, TR SAGEFIELD, TL CACTUS, TR BLUFF CT., 3RD LOT ON RIGHT

SUBDIVISION SAGE FOREST BLOCK / SECTION II LOT # 15 LOT AREA 0.495 ACRE DESIGN FLOW 360 L.T.A.R. 0.30 GAD/FT²

Septic Tank 1000 Gallons: STB 160 Date 2/16/11
Pump Tank ____ Gallons: P T ____ Date ____
Pump Make ____ Model ____ Serial # ____
No. Nitrification Fields: 1 No. Lines 5 Linear Feet 300
Trench Width 36" Max. Trench Bottom Depth 20" Gravel Depth N/A

☑ New System ☐ Repair ☐ Expansion System Type I II (III) IV V VI
System Description: 25% REDUCTION, GRAVITY
Repair System Description: 25% REDUCTION, PUMP
Maintenance Agreement Required ☐ YES ☑ NO
☑ GRAVITY ☐ PRESSURE

☑ Residence No. Bedrooms 3
☐ Business No. Persons ____
☐ Other No. Employees ____
☐ Slab ☑ Crawl Space
☐ Basement w/plumbing ☐ Basement w/o plumbing


Water Supply: ☐ Private ☑ Public ☐ Community

Comments / Conditions: INSTALL 25% REDUCTION SYSTEM ON CONTOUR AS SHOWN, USING SERIAL DISTRIBUTION

INSTALL LINES NO DEEPER THAN 20 INCHES

SEPTIC TANK WITH MARKER INSTALLED USING RED "POLYLOK" RISER

INITIAL SITE SKETCH

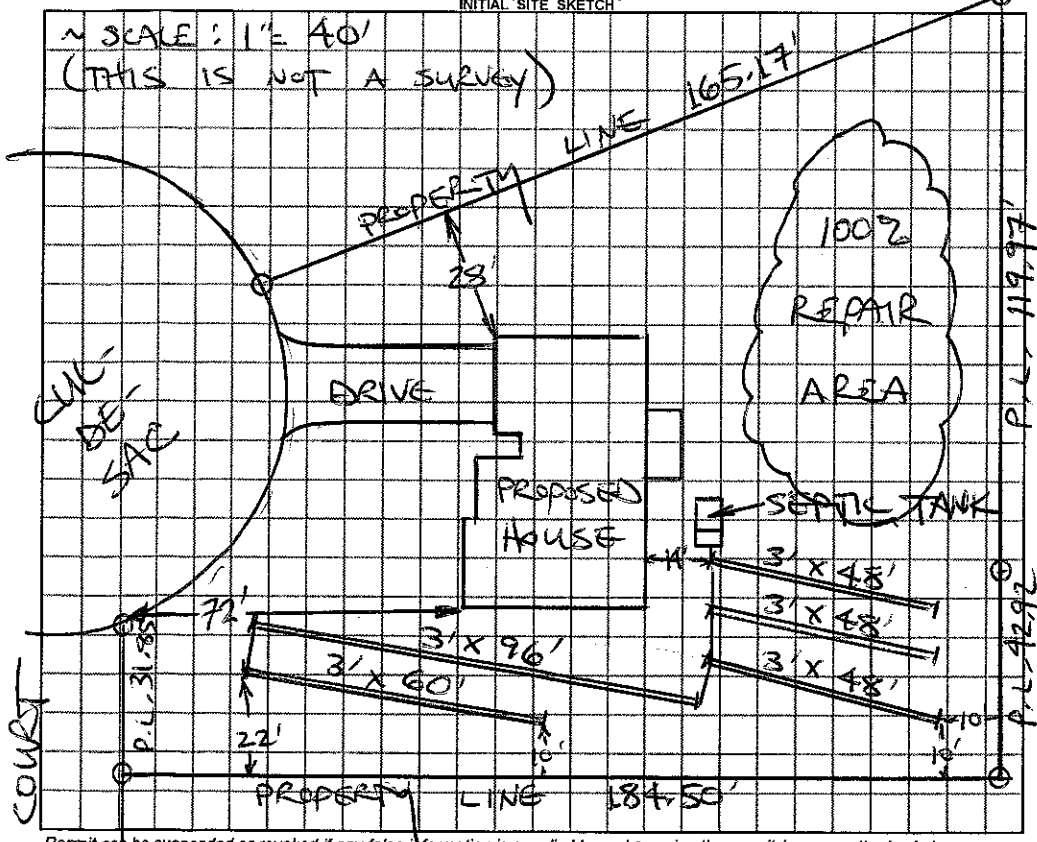

AS BUILT SKETCH

SYSTEM INSTALLED ACCORDING TO INITIAL SITE SKETCH

Permit can be suspended or revoked if any false information is supplied toward securing the permit / any unauthorized changes are made to the site / any unauthorized changes are made in the installation of the system.

☐ ***IMPROVEMENT PERMIT*** *with plat valid without expiration.* ☑ ***IMPROVEMENT PERMIT*** *with plat valid ~~without expiration~~ 60 mos.* ☐ ***AUTHORIZATION TO CONSTRUCT*** valid for period equal to IMPROVEMENT PERMIT--not to exceed 60 mo.

Owner / Applicant Signature: Bruce Porter Date 2-9-11 Installed by: TOMMY COTHREN

IMPROVEMENT PERMIT by: STEVE HEDRICK REHS Date 2-8-2011 OPERATION PERMIT by: STEVE HEDRICK REHS Date 5/20/11

AUTHORIZATION TO CONSTRUCT by: STEVE HEDRICK REHS Date 2-8-2011 Existing System Inspected by: ____ REHS Date ____

YOU SHOULD CONTACT A LOCATOR SERVICE PRIOR TO ANY EXCAVATION

White Copy – Environmental Health YELLOW COPY (Final) Owner / Applicant PINK COPY (Initial) Owner / Applicant