IREDELL COUNTY HEALTH DEPARTMENT - *ENVIRONMENTAL HEALTH* ☑ STATESVILLE OFFICE 704-878-5305 ☐ MOORESVILLE OFFICE 704-664-5281

IMPROVEMENT PERMIT / AUTHORIZATION TO CONSTRUCT / OPERATION PERMIT / EXISTING SYSTEM INSPECTION

PERMIT # 17180530 PIN # 4776813660 DATE 4-30-12

OWNER Bruce Porter APPLICANT: Bruce Porter PHONE: Home/Cell # 704-878-9314 Business #

SITE ADDRESS 111 Cactus Ln. Statesville NC 28625 OWNER / APPLICANT ADDRESS 2143 Mocksville Hwy Statesville NC 28625


SITE DIRECTIONS Mocksville Hwy E, (L) on Swann; (R) on Sagefield; (L) on Cactus; on left

SUBDIVISION Sage Forest BLOCK / SECTION Phase 2 LOT # 19 LOT AREA .82 DESIGN FLOW 360 gpd L.T.A.R. .25

Septic Tank 1000	Gallons: STB 160	Date 4-20-12	☑ New System	☐ Repair	☐ Expansion System	Type I II (III) IV V VI	☐ Residence	No. Bedrooms 3	Water Supply		
Pump Tank	Gallons: P T	Date	System Description: 25% Reduction				☐ Business	No. Persons 6	☐ Private		
Pump Make	Model	Serial #	Repair System Description: 50% Reduction (Pump)				☐ Other	No. Employees	☑ Public		
No. Nitrification Fields: 1	No. Lines 4	Linear Feet 360	Maintenance Agreement Required ☐ YES ☑ NO				☐ Slab	☑ Crawl Space	☐ Community		
Trench Width 36"	Max. Trench Bottom Depth 30"		Gravel Depth N/A	☑ GRAVITY	☐ PRESSURE		☐ Basement w/plumbing		☐ Basement w/o plumbing		

Comments / Conditions: Install 25% Red. system on Contour w/ Serial distribution.

INITIAL SITE SKETCH

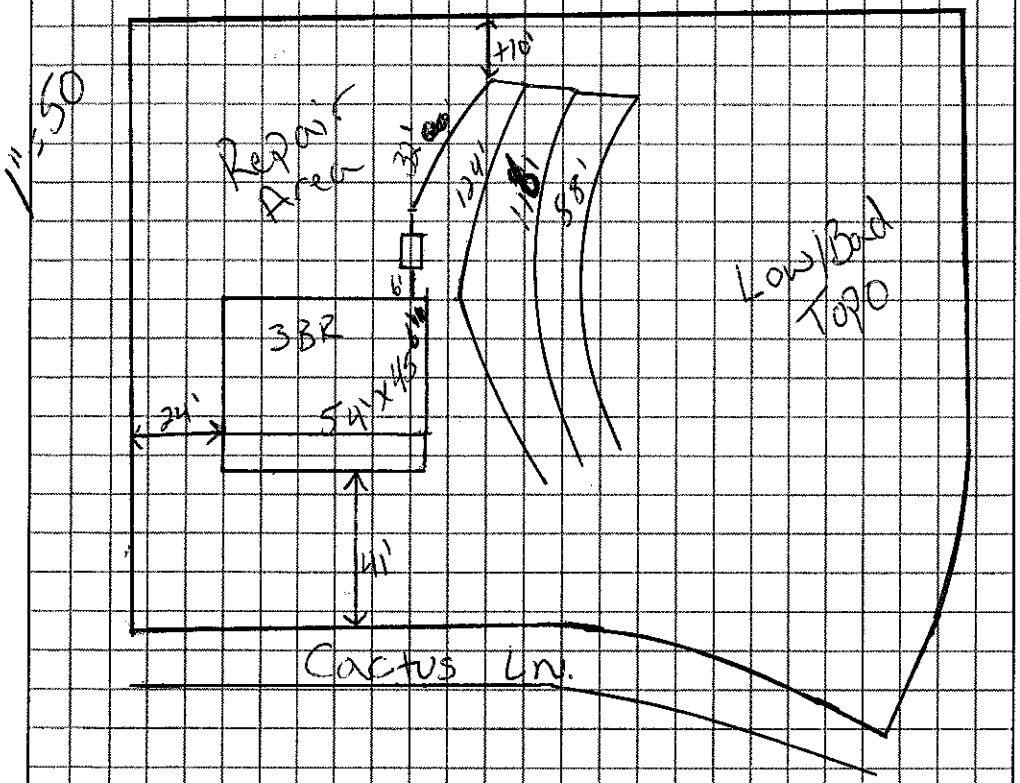

AS BUILT SKETCH

- Red Poly Lok filter installed
- Quick 4 Chambers installed
- 2" PVC S.T. marker installed
- Installed as drawn

Permit can be suspended or revoked if any false information is supplied toward securing the permit / any unauthorized changes are made to the site / any unauthorized changes are made in the installation of the system.

☐ ***IMPROVEMENT PERMIT*** with plat valid without expiration. ☑ ***IMPROVEMENT PERMIT*** with plat valid without expiration. site plan valid 60 mo. ☑ ***AUTHORIZATION TO CONSTRUCT*** valid for period equal to IMPROVEMENT PERMIT--not to exceed 60 mo.

Owner / Applicant Signature: Bruce Porter Date 5-1-12 Installed by: Coltheran & Son Grading

IMPROVEMENT PERMIT by: Justin Henderson REHS Date 4-30-12 OPERATION PERMIT by: Justin Henderson REHS Date 1-22-13

AUTHORIZATION TO CONSTRUCT by: Justin Henderson REHS Date 4-30-12 Existing System Inspected by: REHS Date

YOU SHOULD CONTACT A LOCATOR SERVICE PRIOR TO ANY EXCAVATION

White Copy – Environmental Health YELLOW COPY (Final) Owner / Applicant PINK COPY (Initial) Owner / Applicant