# IREDELL COUNTY HEALTH DEPARTMENT

Statesville Office (704) 878-5305 Mooresville Office (704) 660-3625 PERMIT # 177926

## IMPROVEMENT PERMIT / AUTHORIZATION TO CONSTRUCT / OPERATION PERMIT / EXISTING SYSTEM

PIN # 4776813894

APPLICANT: NCU INC APPLICANT ADDRESS: PO Box 64 Steinhatchee FL

SITE ADDRESS: 13 Buff Ct. PHONE: 352-692-3132 ALT. PHONE: N/A


SITE DIRECTIONS: Hwy 64 E TL Swann Rd TR Sagefield Dr. TL Cactus Ln TL Buff Ct.

SUBDIVISION: Sage Forest SECTION: 2 LOT # 14 LOT AREA: 0.76 acres DESIGN FLOW: 360gpd L.T.A.R.: 0.25

| | | | | | | | | | | | |
|---|---|---|---|---|---|---|---|---|---|---|---|
| Septic Tank | 1000 (gal) | STB 100-1000 | Date 3-8-13 | ☑ New System | ☐ Repair | ☐ Expansion | System Type: I II (III) IV V VI | ☑ Residence | No. Bedrooms 3 | Water Supply | |
| Pump Tank | (gal) | PT | Date | System Description: 25% Reduction | | | | ☐ Business | No. Persons | ☐ Private | |
| Pump Make | Model | | Serial # | Repair System Description: 25% Reduction | | | | ☐ Other | No. Employees | ☑ Public | |
| # Nitrification Fields 1 | # Lines 5 | | Linear Ft: 360 | Maintenance Agreement Required: | ☐ YES | ☑ NO | | ☐ Slab | ☑ Crawl Space | ☐ Community | |
| Trench Width 36" | Max. Trench Bottom Depth 36" | | Gravel Depth N/A | | ☑ GRAVITY | ☐ PRESSURE | | ☐ Basement w/plumbing | | ☐ Basement w/o plumbing | |

Comments / Conditions: Install a 25% Reduction system on Contour with serial distribution.

INITIAL SITE SKETCH

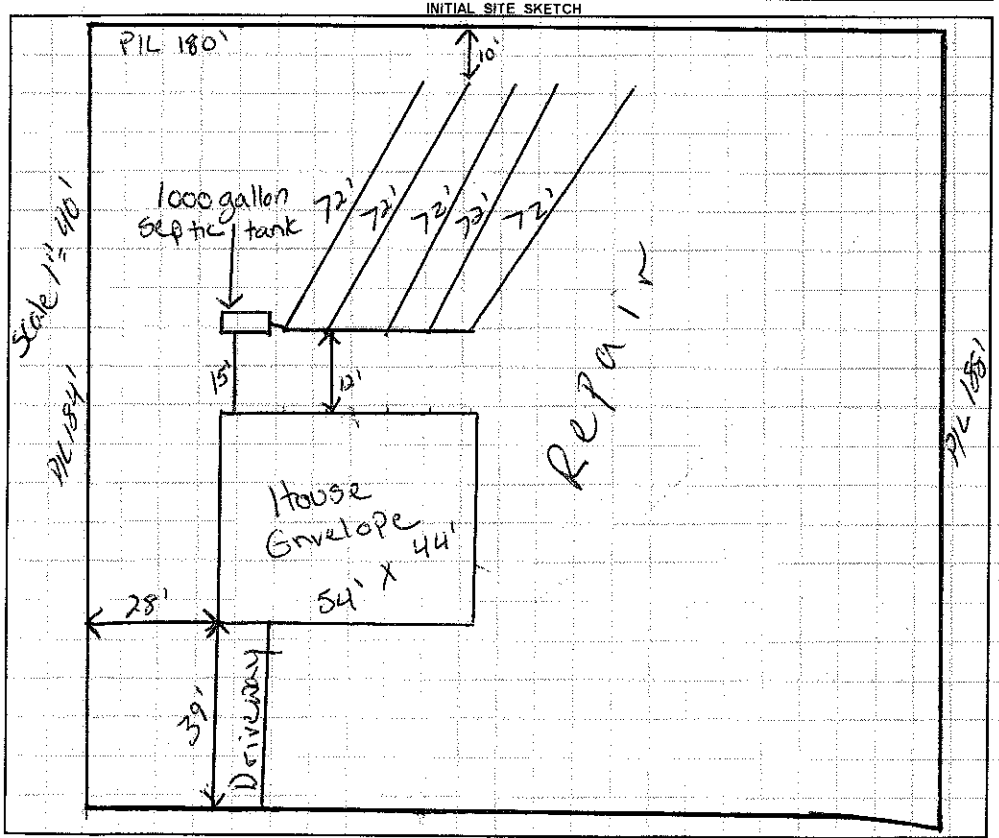


AS BUILT SKETCH

- Red Polylok filter installed
- Quick4 Chambers installed.
- 2" PVC septic tank marker installed
- Installed as drawn

*Permit can be suspended or revoked if any false information is supplied toward securing the permit / any unauthorized changes are made to the site / any unauthorized changes are made in the installation of the system.* **CONTACT A LOCATOR SERVICE PRIOR TO ANY EXCAVATION**

☐ **IMPROVEMENT PERMIT** *with plat valid without expiration.* ☑ **IMPROVEMENT PERMIT** *with site plan valid for 60 mos.* ☑ **AUTHORIZATION TO CONSTRUCT** *valid for period equal to IMPROVEMENT PERMIT--not to exceed 60 mo.*

Owner / Applicant Signature: Bruce Port Date: 4-15-13 Installed by: Cathren + Son Grading

IMPROVEMENT PERMIT by: Justin Henderson Date: 4-12-13 OPERATION PERMIT by: Justin Henderson Date: 6-21-13

AUTHORIZATION TO CONSTRUCT by: Justin Henderson Date: 4-12-13 Existing System Inspected by: Date:

Health Dept. Copy - WHITE Applicant (Final Approval) - YELLOW Applicant (Conditional Approval) - PINK