IREDELL COUNTY HEALTH DEPARTMENT

STATESVILLE 704-878-5305 MOORESVILLE 704-664-5281

IMPROVEMENT PERMIT / AUTHORIZATION TO CONSTRUCT / OPERATION PERMIT / EXISTING SYSTEM INSPECTION

PERMIT # 155455 PIN # 4776-81-4200 DATE 5 29 09

OWNER or APPLICANT Bruce Poter PHONE: Business Home: 704-878-9314

OWNER or APPLICANT ADDRESS 2143 Mockaville Hwy Statesville 28625

LOCATION / DIRECTIONS 64 E (R) Swann RD (R) Sidefield on right

SUBDIVISION Sage Forest BLOCK / SECTION II LOT # 5 LOT AREA .504 DESIGN FLOW 360 L.T.A.R. .25

Septic Tank 1000 Gallons: STB 1000 Date 7-11-07

Pump Tank ____ Gallons: P T ____ Date ____

Pump Make ____ Model ____ Serial # ____

Nitrification Field No Fields ____ No Lines 6 Linear Feet 360

Trench Width 36" Max. Trench Bottom Depth 36" Gravel Depth 36" ☑ GRAVITY ☐ PRESSURE

☐ New System ☐ Repair ☐ Expansion System Type I II III IV V VI

System Description: 25% Conv .25

Repair System Description: 25% Conv (.3 Mm)

Maintenance Agreement Required ☐ YES ☐ NO

☒ Residence No. Bedrooms 3

☐ Business No. Persons ____

☐ Other No. Employees ____

☐ Slab ☒ Crawl Space

☐ Basement w/plumbing ☐ Basement w/o plumbing


Water Supply: ☐ Private ☒ Public ☐ Community

Comments / Conditions


Comments / Conditions

Install on Contour
Maintain all Setback

INITIAL SITE SKETCH

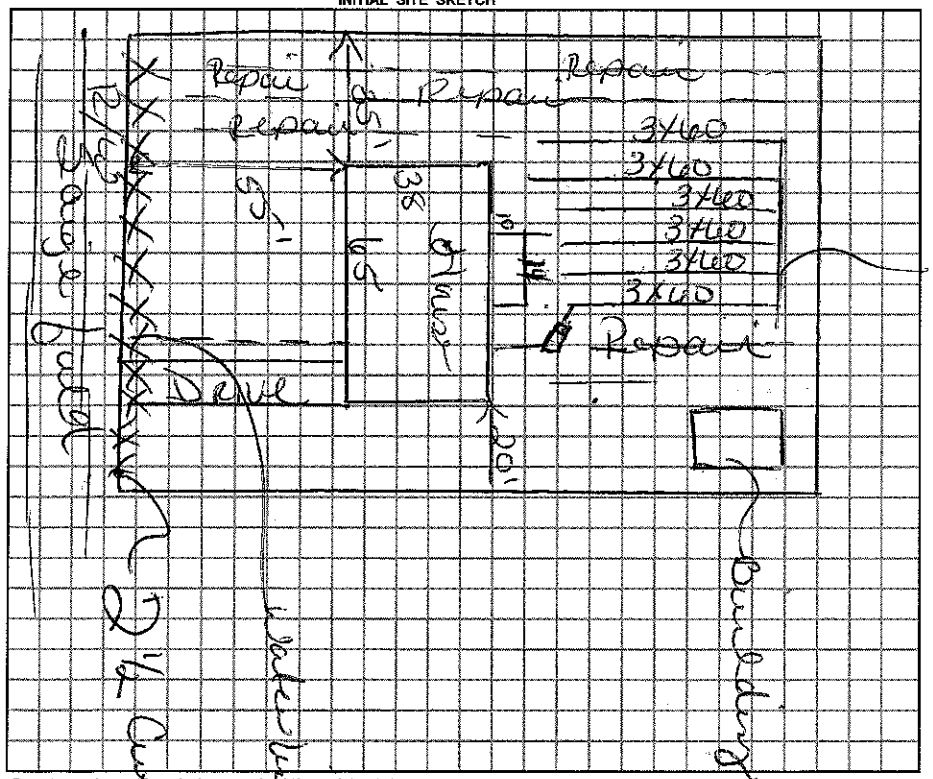

AS BUILT SKETCH

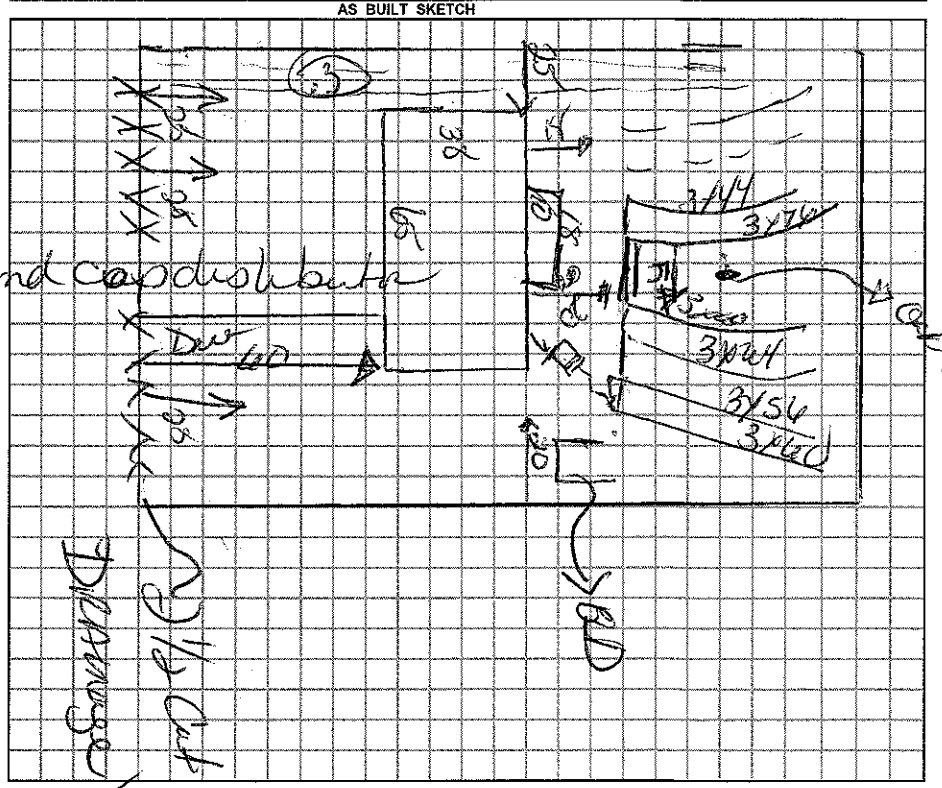

Permit can be suspended or revoked if any false information is supplied toward securing the permit / any unauthorized changes are made to the site / any unauthorized changes are made in the installation of the system.

☐ *IMPROVEMENT PERMIT w / plat valid without expiration.* ☒ *IMPROVEMENT PERMIT w / site plan valid for 60 mos.* ☒ *AUTHORIZATION TO CONSTRUCT valid for period equal to IMPROVEMENT PERMIT-not to exceed 60 mo.*

Owner / Applicant Signature: Bruce Poter Date 5-29-09

Improvement Permit by: Date 5-29-09

Authorization to Construct by: Date 5-29-09

Installed by: Tommy Cothron

Operation Permit by: Date: 10-5-09

Existing System Inspected by: Date:

YOU SHOULD CONTACT A LOCATOR SERVICE PRIOR TO ANY EXCAVATION.

WHITE COPY Environmental Health YELLOW COPY (Final) Owner / Applicant PINK COPY (Initial) Owner / Applicant