IREDELL COUNTY HEALTH DEPARTMENT

Statesville Office (704) 878-5305 Mooresville Office (704) 660-3625 PERMIT # 177642

IMPROVEMENT PERMIT / AUTHORIZATION TO CONSTRUCT / OPERATION PERMIT / EXISTING SYSTEM

PIN # 4776 81 44 01

APPLICANT: Bruce Porter APPLICANT ADDRESS: 2143 Mocksville Hwy. Statesville, NC 28625

SITE ADDRESS: 105 Cactus Ln PHONE: 704-878-9314 ALT. PHONE:

SITE DIRECTIONS: 64E, (L) on Swann, (R) on Sagefield, on corner of Sagefield and Cactus


SUBDIVISION: Sage Forest SECTION: 2 LOT # 20 LOT AREA: .738 DESIGN FLOW: 360 L.T.A.R.: .3

Septic Tank	1000 (gal)	STB	160	Date	4-18-13	☒ New System	☐ Repair	☐ Expansion	System Type: I II (III) IV V VI	☒ Residence	No. Bedrooms 3
Pump Tank	(gal)	PT		Date		System Description:	25% Red. Gravity			☐ Business	No. Persons
Pump Make		Model		Serial #		Repair System Description:	25% Red. Pump			☐ Other	No. Employees
# Nitrification Fields	1	# Lines	3	Linear Ft:	300	Maintenance Agreement Required:	☐ YES	☒ NO		☐ Slab	☒ Crawl Space
Trench Width	36"	Max. Trench Bottom Depth	36"	Gravel Depth	n/a	☒ GRAVITY	☐ PRESSURE			☐ Basement w/plumbing	☐ Basement w/o plumbing


Water Supply: ☐ Private ☒ Public ☐ Community

Comments / Conditions:

INITIAL SITE SKETCH

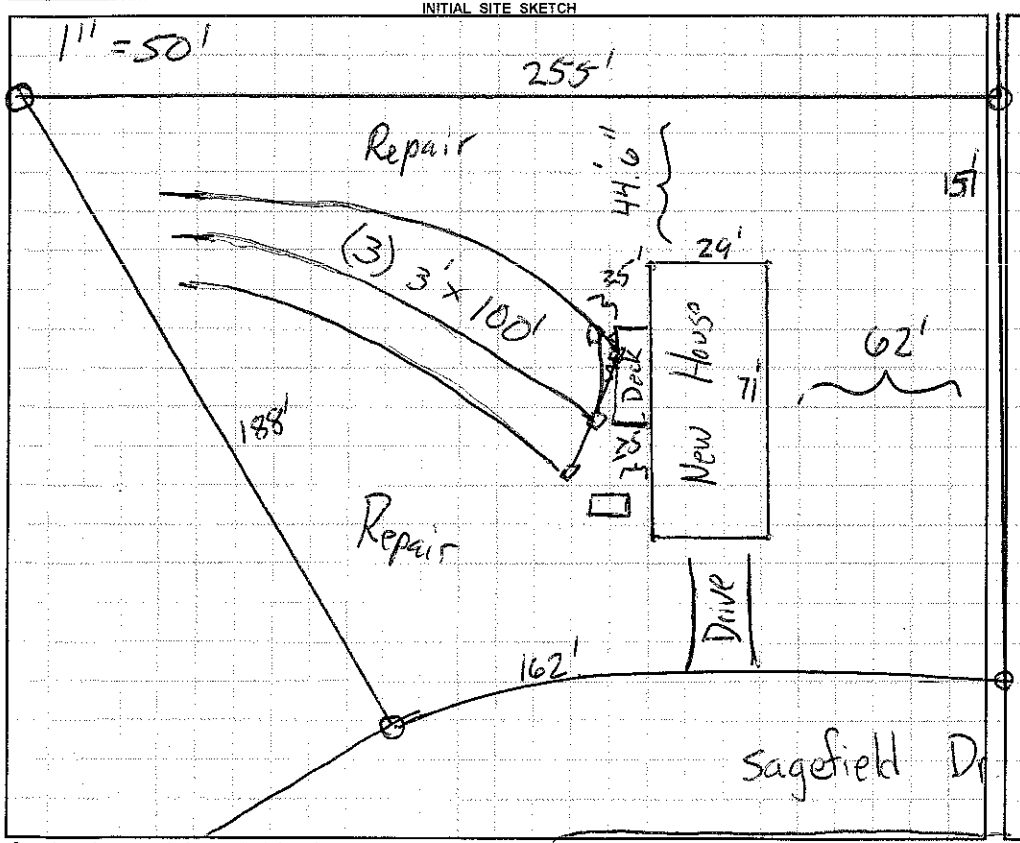

AS BUILT SKETCH

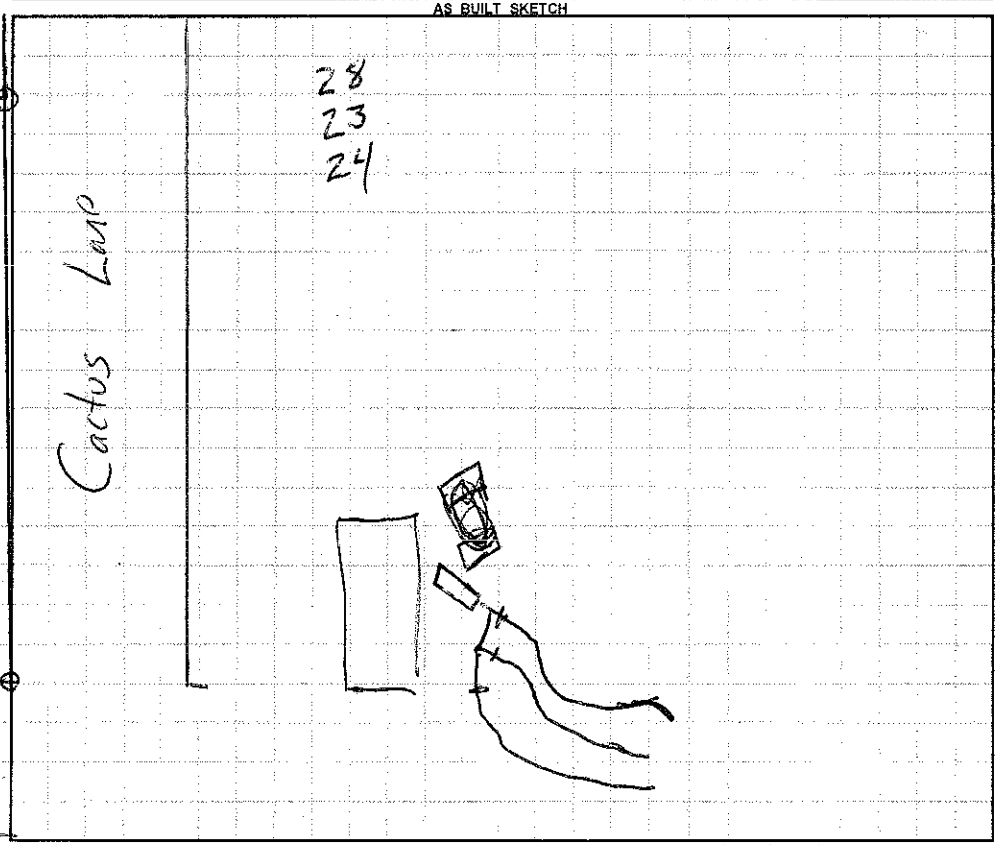

Permit can be suspended or revoked if any false information is supplied toward securing the permit / any unauthorized changes are made to the site / any unauthorized changes are made in the installation of the system. **CONTACT A LOCATOR SERVICE PRIOR TO ANY EXCAVATION**

☐ **IMPROVEMENT PERMIT** ***with plat*** *valid without expiration.* ☒ **IMPROVEMENT PERMIT** ***with site plan*** *valid for 60 mos.* ☒ **AUTHORIZATION TO CONSTRUCT** *valid for period equal to IMPROVEMENT PERMIT--not to exceed 60 mo.*

Owner / Applicant Signature: Bruce Porter Date: 4-5-13 Installed by: Cothren & Sons

IMPROVEMENT PERMIT by: Date: 4-4-13 OPERATION PERMIT by: Date: 6-28-13

AUTHORIZATION TO CONSTRUCT by: Date: 4-4-13 Existing System Inspected by: Date:

Health Dept. Copy - WHITE Applicant (Final Approval) - YELLOW Applicant (Conditional Approval) - PINK