IREDELL COUNTY HEALTH DEPARTMENT

STATESVILLE 704-878-5305 MOORESVILLE 704-664-5281

IMPROVEMENT PERMIT / AUTHORIZATION TO CONSTRUCT / OPERATION PERMIT / EXISTING SYSTEM INSPECTION

PERMIT # 158798 PIN # 4776-81-6148 DATE 18 November 09

OWNER or APPLICANT WCV, Inc. / Bruce Porter PHONE: Business (704) 902-3124 Home:

OWNER or APPLICANT ADDRESS PO Box 64 Steinhatchee, Fl 32359

LOCATION / DIRECTIONS Hwy 64E TL Swann Rd. TR Sagefield Dr. Go to end of street - on RT.


SUBDIVISION Sage Forest BLOCK / SECTION 2 LOT # 7 LOT AREA 0.52ac. DESIGN FLOW 300g/d. L.T.A.R. 0.25g/ft²/d

Septic Tank	1000	Gallons: STB	160	Date	10-30-09	☑ New System ☐ Repair ☐ Expansion System Type I II (III) IV V VI	☑ Residence No. Bedrooms 3 ☐ Business No. Persons ☐ Other No. Employees ☐ Slab ☑ Crawl Space ☐ Basement w/plumbing ☐ Basement w/o plumbing
Pump Tank		Gallons: PT		Date		System Description: 25% Reduction	Water Supply: ☐ Private ☑ Public ☐ Community
Pump Make		Model		Serial #		Repair System Description: 50% Reduction	
Nitrification Field	No Fields 1	No Lines 6	Linear Feet 360			Maintenance Agreement Required ☐ YES ☑ NO	
Trench Width	24"	Max. Trench Bottom Depth	36"	Gravel Depth	N/A	☑ GRAVITY ☐ PRESSURE	


Comments / Conditions * Follow contour / USE Drop-boxes

Comments / Conditions

INITIAL SITE SKETCH

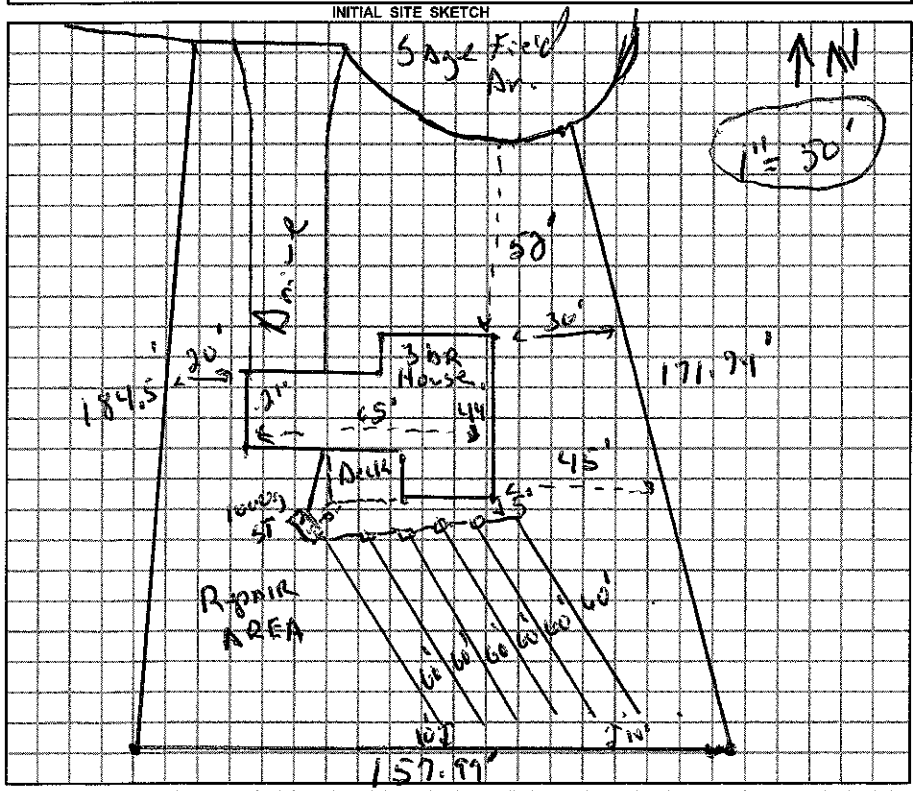

AS BUILT SKETCH

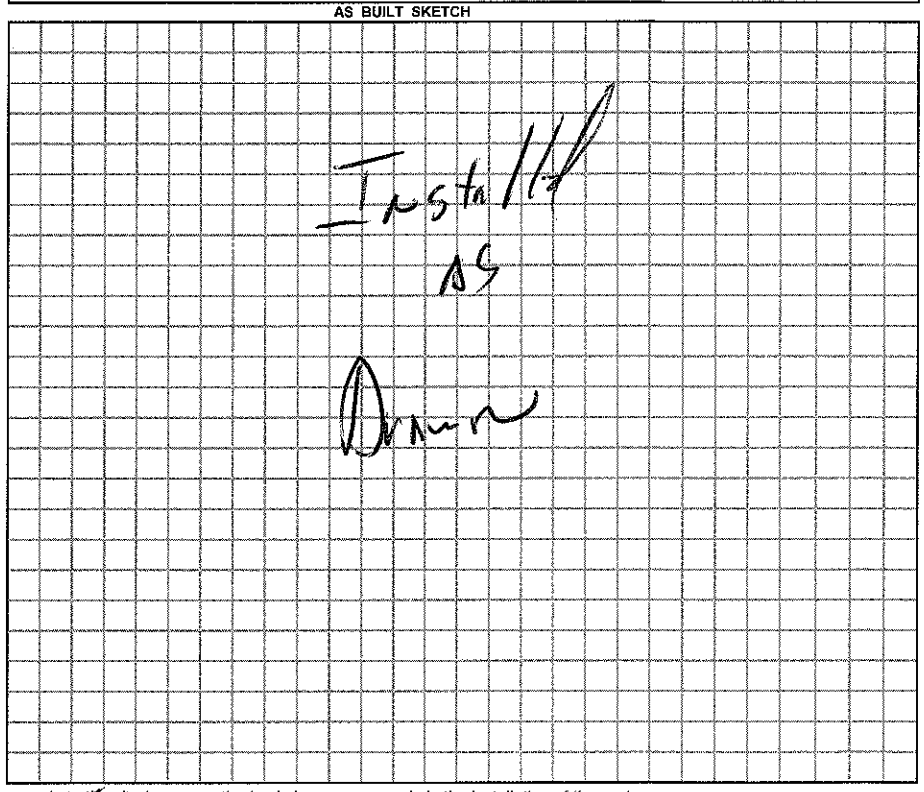

Permit can be suspended or revoked if any false information is supplied toward securing the permit / any unauthorized changes are made to the site / any unauthorized changes are made in the installation of the system.

☐ *IMPROVEMENT PERMIT w / plat valid without expiration.* ☑ *IMPROVEMENT PERMIT w / site plan valid for 60 mos.* ☑ *AUTHORIZATION TO CONSTRUCT valid for period equal to IMPROVEMENT PERMIT-not to exceed 60 mo.*

Owner / Applicant Signature: Bruce Porter Date 11-18-09

Improvement Permit by: [signature], R.S. Date 18 Nov. 09

Authorization to Construct by: [signature], R.S. Date 18 Nov. 09

Installed by: Joey Cothren

Operation Permit by: [signature], R.S. Date: 15 Apr-10

Existing System Inspected by: Date:

YOU SHOULD CONTACT A LOCATOR SERVICE PRIOR TO ANY EXCAVATION.

WHITE COPY Environmental Health YELLOW COPY (Final) Owner / Applicant PINK COPY (Initial) Owner / Applicant