IREDELL COUNTY HEALTH DEPARTMENT

STATESVILLE 704-878-5305 MOORESVILLE 704-664-5281

IMPROVEMENT PERMIT / AUTHORIZATION TO CONSTRUCT / OPERATION PERMIT / EXISTING SYSTEM INSPECTION

KC -2-3-09

PERMIT# 152607 PIN# 4776816472 DATE 9-17-08

OWNER OR APPLICANT WCH, INC PHONE: Business 704-873-2002 Home

ADDRESS 1712 Island Ford Rd Statesville NC 28625

LOCATION I-40 E Exit Swann Rd Across Stage field

SUBDIVISION Sagefield BLOCK / SECTION II LOT 21 LOT AREA SITE CLASS. B DESIGN FLOW 360 L.T.A.R.

Septic Tank: 1000 Gallons: STB 1000 Date 12-08

Pump Tank: Gallons: PT Date

Pump Make: Model Serial No.

Nitrification Field: No Fields 1 Square Feet 1140 Linear Feet 360

No Lines 4 Trench Width 36" Max Trench Bottom Depth 36"

☑ New System ☐ Repair ☐ Expansion System Type: I II III IV V VI

System Description: 2500 Gravity

Repair System Description: 3570 Gravity/pump

Maintenance Agreement Required: ☐ Yes ☐ No

☐ House/Mod. Home No. Bedrooms

☐ Mobile Home No. Persons

☐ Business No. Employees

☐ Other

Water Supply: ☐ Individual ☑ Public ☐ Community


Gravel Depth N/A ☑ Gravity ☐ Pressure ☐ Slab ☑ Crawl Space ☐ Basement w/plumbing ☐ Basement wo/plumbing

Comments:/Conditions:


Comments:/Conditions:

Install on contour Maintain all offsets Rake Sed Wall

INITIAL SITE SKETCH

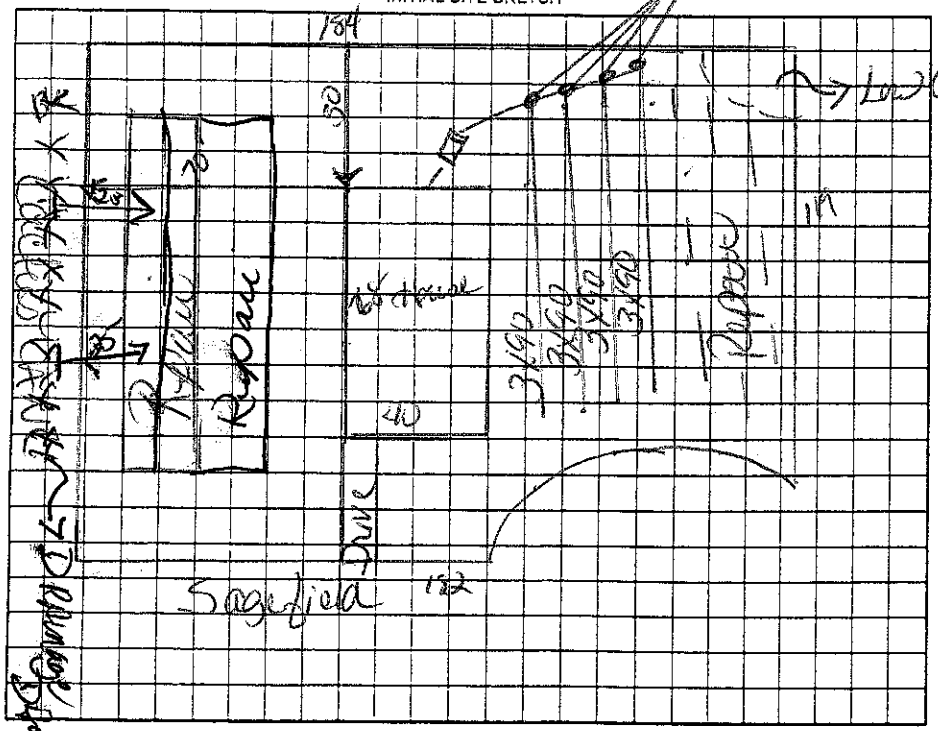

AS BUILT SKETCH

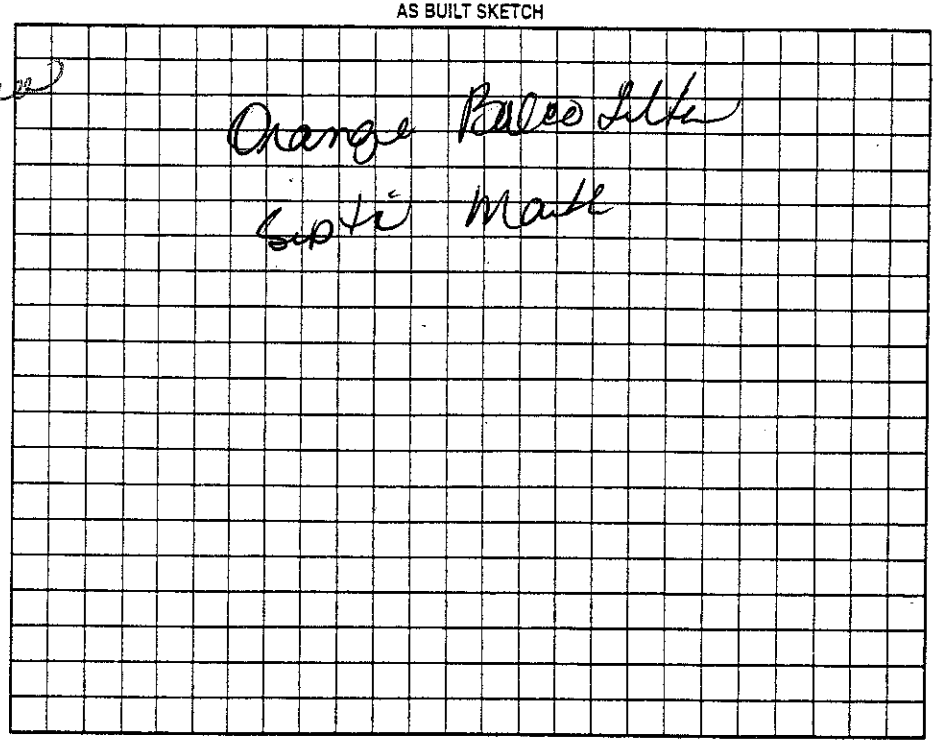

Permit can be suspended or revoked if any false information is supplied toward securing the permit/any unauthorized changes are made to the site/any unauthorized changes are made in the installation of the system. Improvement Permit with plat valid without expiration ☐ Improvement Permit with site plan valid for sixty months ☑ Authorization to Construct is valid for a period equal to that of Improvement Permit – not to exceed sixty months.

Signed: Bruce Poston date 9-17-08 Installed by: Tommy Cuthrell

Improvement Permit by: Keith Cook date 9-17-08 Operation Permit by: Keith Cook date 2-3-09

Authorization to Construct by: Keith Cook date 9-17-08 Existing System Inspection by: date

HEALTH DEPT. COPY: WHITE OWNER COPY (FINAL): YELLOW OWNER COPY (INITIAL): PINK