IREDELL COUNTY HEALTH DEPARTMENT

STATESVILLE 704-878-5305 MOORESVILLE 704-664-5281

IMPROVEMENT PERMIT / AUTHORIZATION TO CONSTRUCT / OPERATION PERMIT / EXISTING SYSTEM INSPECTION

PERMIT# 152609 PIN# 4776816533 DATE 9-18-08

OWNER OR APPLICANT Bruce Porter PHONE: Business 704-878-9314 Home

ADDRESS 2143 Mocksville Hwy 28625

LOCATION 64 E - (L) Swann (R) Sawgrass (L) Cactus 2nd lot on Right

SUBDIVISION Sage Forest BLOCK / SECTION 2 LOT 22 LOT AREA SITE CLASS. PS DESIGN FLOW 360 L.T.A.R.

Septic Tank: 1000 Gallons; STB Date 1-11-09
Pump Tank: Gallons; PT Date
Pump Make: Model Serial No.
Nitrification Field: No Fields Square Feet 1440 Linear Feet 360
No Lines 4 Trench Width 36" Max Trench Bottom Depth 30"

☑ New System ☐ Repair ☐ Expansion System Type: I II (III) IV V VI
System Description: 25% Gravel
Repair System Description: 25% Gravel / pump
Maintenance Agreement Required: ☐ Yes ☐ No
Gravel Depth NA ☐ Gravity ☐ Pressure ☐ Slab ☑ Crawl Space ☐ Basement w/plumbing ☐ Basement wo/plumbing

☑ House/Mod. Home ☐ Mobile Home ☐ Business ☐ Other


No. Bedrooms 3 No. Persons No. Employees

Water Supply: ☐ Individual ☑ Public ☐ Community

Comments:/Conditions:

Comments:/Conditions:
Install on Contour
Maintain all setbacks
Rate Side walls

INITIAL SITE SKETCH

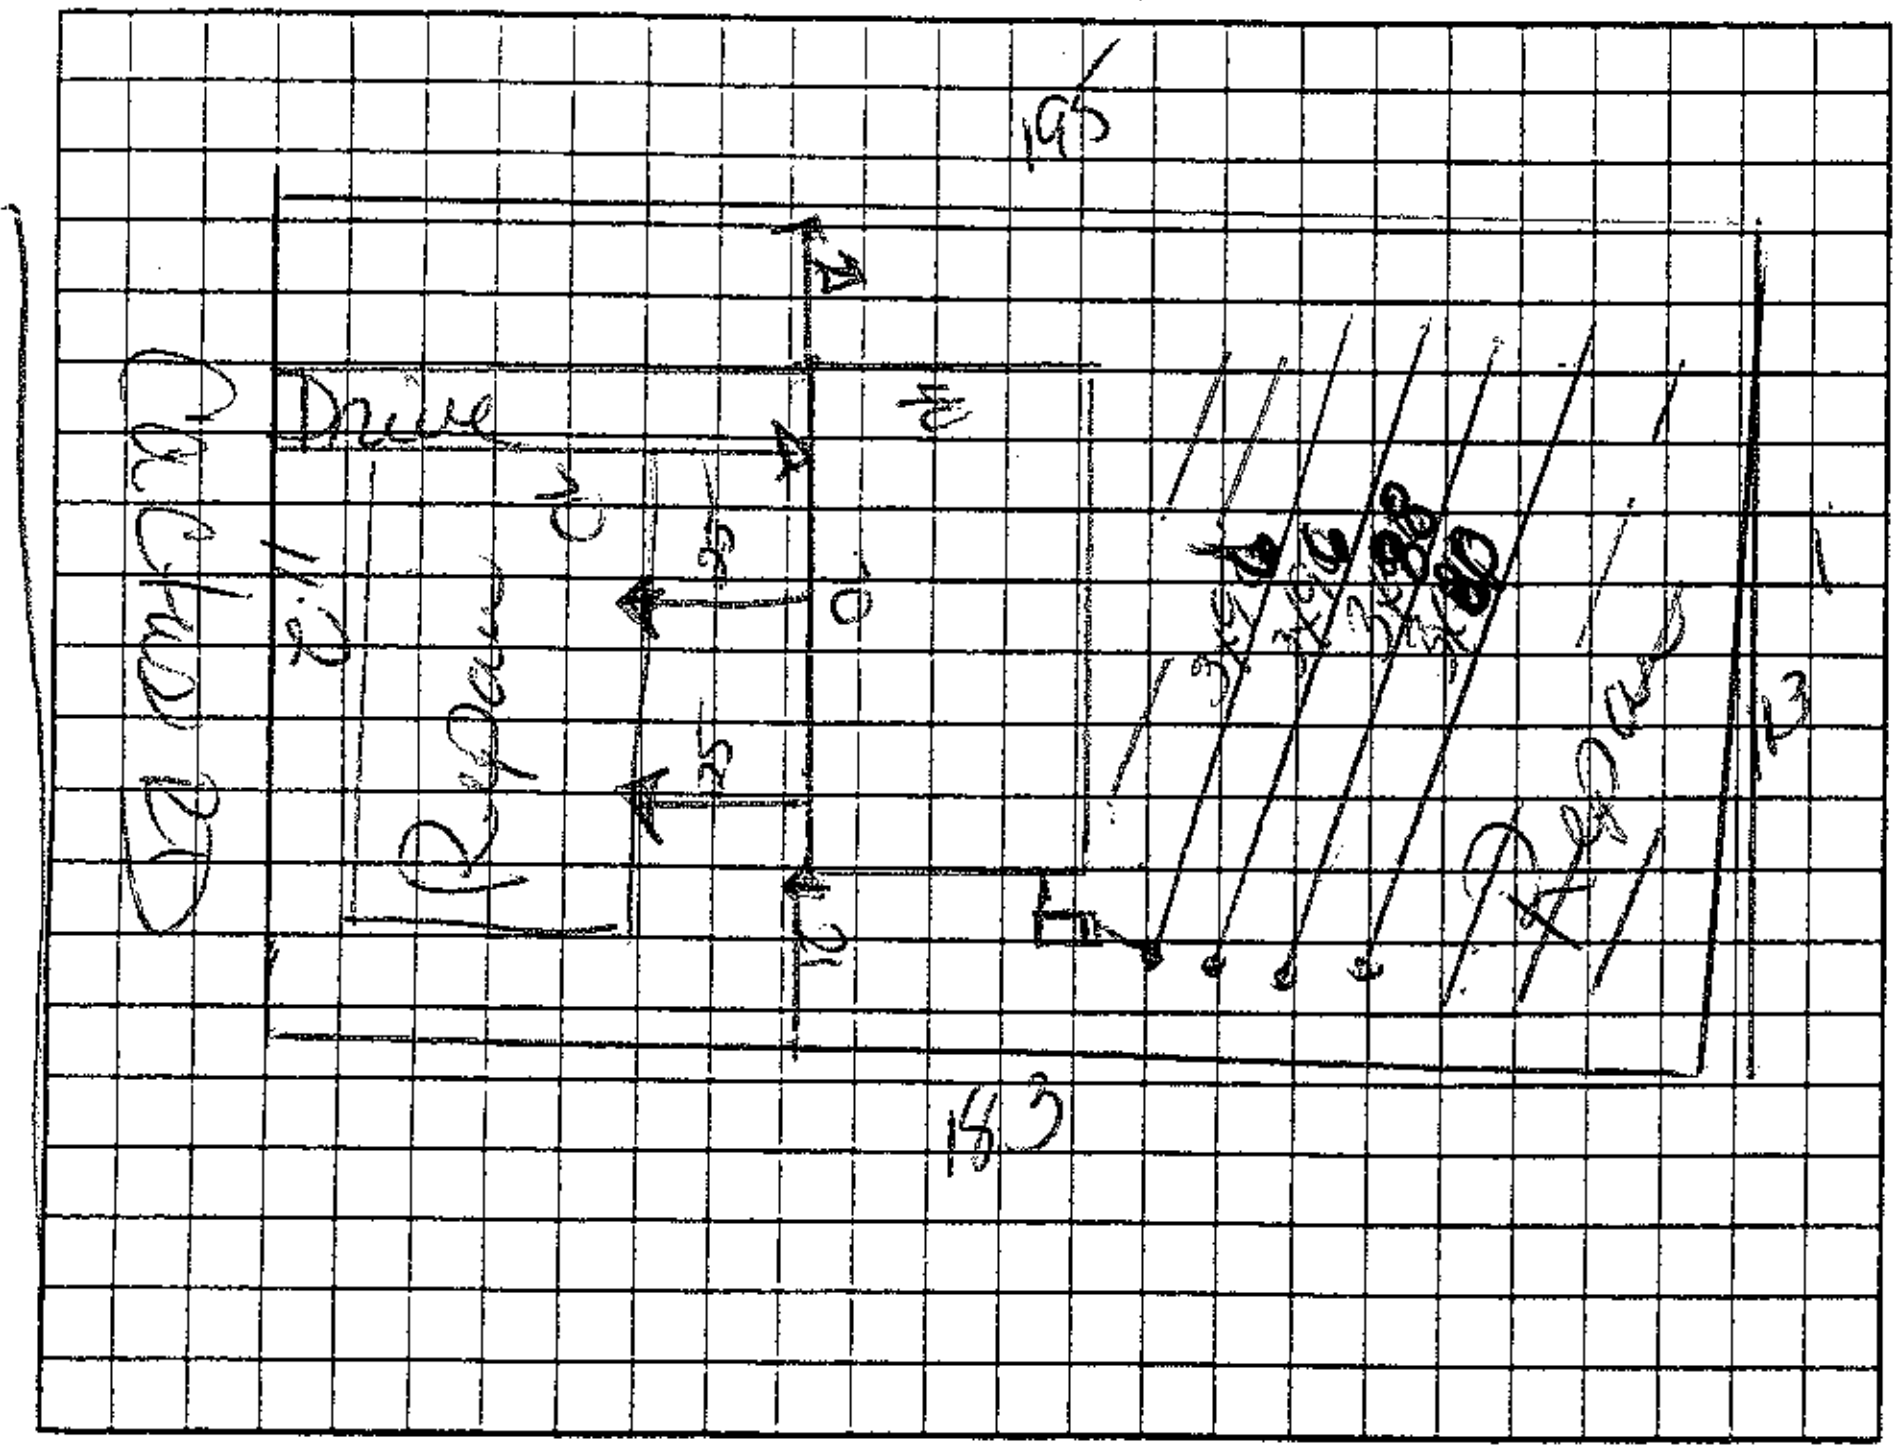

AS-BUILT SKETCH

Septic marked
Orange Ball Fill

Permit can be suspended or revoked if any false information is supplied toward securing the permit/any unauthorized changes are made to the site/any unauthorized changes are made in the installation of the system. Improvement Permit with plat valid without expiration ☐ Improvement Permit with site plan valid for sixty months ☑ Authorization to Construct is valid for a period equal to that of Improvement Permit – not to exceed sixty months.

Signed: Bruce Porter date 9-17-08 Installed by: Tommy Collins

Improvement Permit by: Kelly Cook date 9-17-08 Operation Permit by: Kelly Cook date 3-20-09

Authorization to Construct by: Kelly Cook date 9-17-08 Existing System Inspection by: date

HEALTH DEPT. COPY: WHITE OWNER COPY (FINAL): YELLOW OWNER COPY (INITIAL): PINK