IREDELL COUNTY HEALTH DEPARTMENT - *ENVIRONMENTAL HEALTH* ☐ STATESVILLE OFFICE 704-878-5305 (C1) ☐ MOORESVILLE OFFICE 704-664-5281

IMPROVEMENT PERMIT / AUTHORIZATION TO CONSTRUCT / OPERATION PERMIT / EXISTING SYSTEM INSPECTION

PERMIT # 164915 PIN # 4776-81-6622 DATE FEBRUARY 8, 2011

OWNER W.C.U. INC APPLICANT: PHONE: Home/Cell # % 704-902-3124 Business # 352-498-0299

SITE ADDRESS 114 CACTUS LANE OWNER / APPLICANT ADDRESS

SITE DIRECTIONS US 64 EAST, TL SWANN ROAD, TR SAGEFIELD DR, TL CACTUS LANE, 3RD LOT ON RIGHT

SUBDIVISION SAGE FOREST BLOCK / SECTION II LOT # 23 LOT AREA 0.504 Ac DESIGN FLOW 360 L.T.A.R. 0.30 GPD/FT²

Septic Tank 1000 Gallons: STB 160 Date 10-7-11

Pump Tank ____ Gallons: P T ____ Date ____

Pump Make ____ Model ____ Serial # ____

No. Nitrification Fields: 1 No. Lines 5 Linear Feet 300

Trench Width 36" Max. Trench Bottom Depth 36" Gravel Depth N/A

☑ New System ☐ Repair ☐ Expansion System Type I II (III) IV V VI

System Description: 25% REDUCTION GRAVITY

Repair System Description: 25% REDUCTION, PUMP

Maintenance Agreement Required ☐ YES ☑ NO

☑ GRAVITY ☐ PRESSURE


☑ Residence No. Bedrooms 3 ☐ Business No. Persons ____ ☐ Other No. Employees ____ ☐ Slab ☑ Crawl Space ☐ Basement w/plumbing ☐ Basement w/o plumbing

Water Supply: ☐ Private ☑ Public ☐ Community


Comments / Conditions: INSTALL 25% REDUCTION SYSTEM AS SHOWN USING EFFLUENT SPLITTER (SUCH AS ZOELLER "TRY-FLO") IN ORDER TO ACHIEVE PARALLEL DISTRIBUTION.

ST HAS MARKER
Poly lock Filter

INITIAL SITE SKETCH

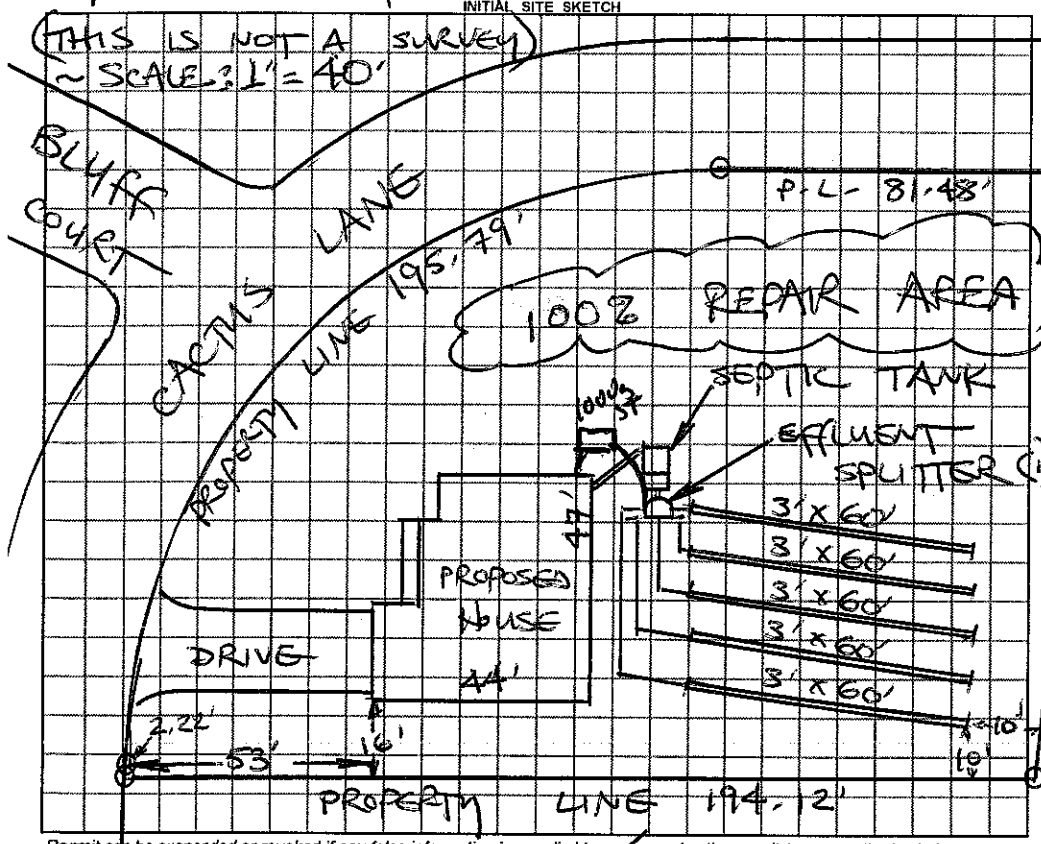

AS BUILT SKETCH

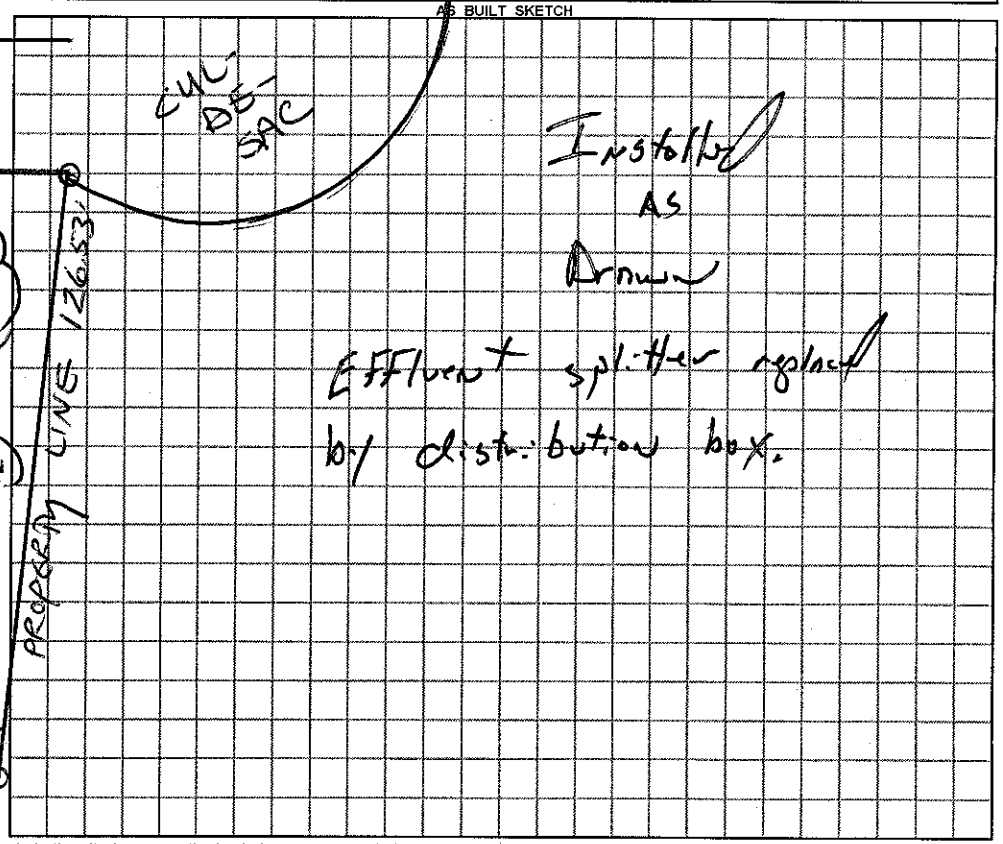

Permit can be suspended or revoked if any false information is supplied toward securing the permit / any unauthorized changes are made to the site / any unauthorized changes are made in the installation of the system.

☐ ***IMPROVEMENT PERMIT*** *with plat valid without expiration.* ☑ ***IMPROVEMENT PERMIT*** *with plat valid ~~without expiration~~.* 60 MOS, ☐ ***AUTHORIZATION TO CONSTRUCT*** valid for period equal to IMPROVEMENT PERMIT--not to exceed 60 mo.

Owner / Applicant Signature: Bruce Fox Date 2-9-11 Installed by: Joey Goforth

IMPROVEMENT PERMIT by: STEVE HEDRICK REHS Date 2-8-2011 OPERATION PERMIT by: REHS Date 27 Jan. 12

AUTHORIZATION TO CONSTRUCT by: STEVE HEDRICK REHS Date 2-8-2011 Existing System Inspected by: REHS Date

YOU SHOULD CONTACT A LOCATOR SERVICE PRIOR TO ANY EXCAVATION

White Copy – Environmental Health YELLOW COPY (Final) Owner / Applicant PINK COPY (Initial) Owner / Applicant