IREDELL COUNTY HEALTH DEPARTMENT - *ENVIRONMENTAL HEALTH* ☑ STATESVILLE OFFICE 704-878-5305 ☐ MOORESVILLE OFFICE 704-664-5281

IMPROVEMENT PERMIT / AUTHORIZATION TO CONSTRUCT / OPERATION PERMIT / EXISTING SYSTEM INSPECTION

PERMIT # 171804 PIN # 4776817834 DATE 5-1-12

OWNER Steve Hart / WCU APPLICANT: Steve Hart / WCU PHONE: Home/Cell # 352-498-0299 Business # 704-902-3124

SITE ADDRESS 125 Cactus Ln. OWNER/APPLICANT ADDRESS PO Box Steinhatchee FL 32359

SITE DIRECTIONS Mocksville Hwy E; (L) on Swann Rd, (R) on Sage field; (L) on Cactus Ln

SUBDIVISION Sage Field BLOCK / SECTION Phase 2 LOT # 12 LOT AREA 0.499 DESIGN FLOW 360gpd. L.T.A.R. 0.25

Septic Tank 1000 Gallons: STB 160 Date 7-13-12
Pump Tank ____ Gallons: PT ____ Date ____
Pump Make ____ Model ____ Serial # ____
No. Nitrification Fields: 1 No. Lines 5 Linear Feet 360'
Trench Width 36" Max. Trench Bottom Depth 24" on low side Gravel Depth N/A

☑ New System ☐ Repair ☐ Expansion System Type I II (III) IV V VI
System Description: 25% Reduction
Repair System Description: 50% Reduction
Maintenance Agreement Required ☐ YES ☑ NO
☑ GRAVITY ☐ PRESSURE


☑ Residence No. Bedrooms 3
☐ Business No. Persons 6
☐ Other No. Employees ____
☐ Slab ☑ Crawl Space
☐ Basement w/plumbing ☐ Basement w/o plumbing

Water Supply: ☐ Private ☑ Public ☐ Community

Comments / Conditions: Install 25% Reduction System on Contour w/ serial distribution

- Red Polylok filter installed
- 2" PVC septic tank marker installed
- Quick 4 panels installed

INITIAL SITE SKETCH

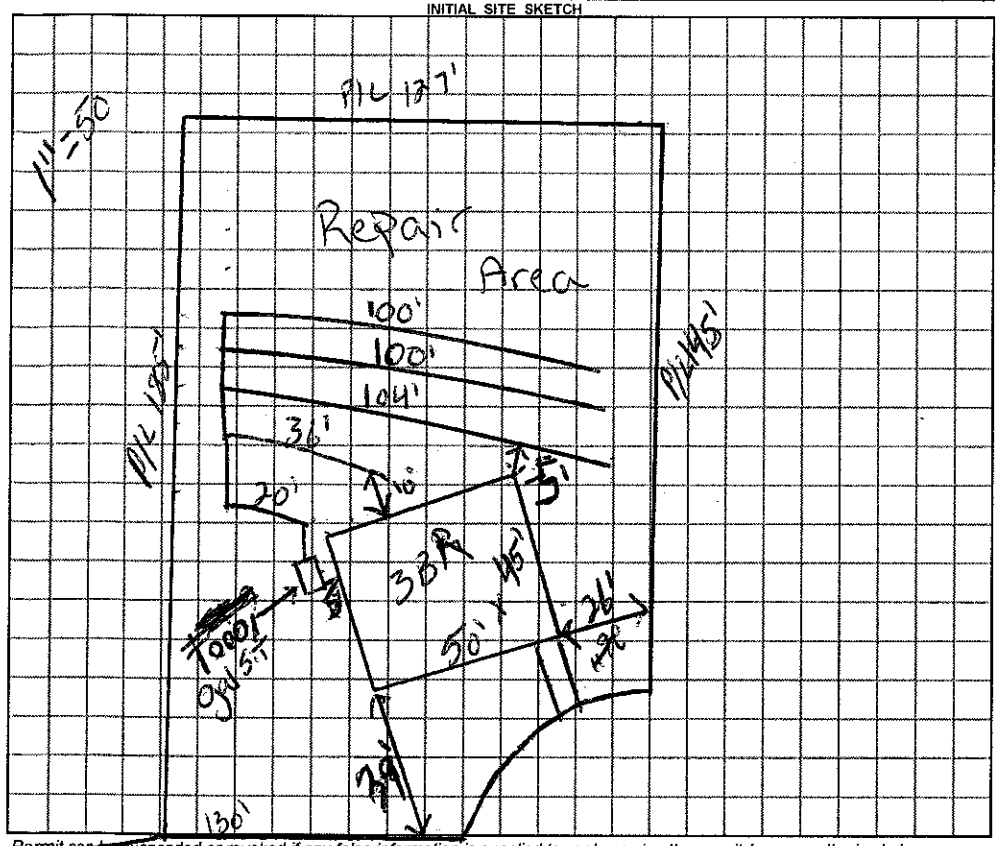

AS BUILT SKETCH

Installed as drawn

Permit can be suspended or revoked if any false information is supplied toward securing the permit / any unauthorized changes are made to the site / any unauthorized changes are made in the installation of the system.

☐ *IMPROVEMENT PERMIT valid without expiration* ☑ *IMPROVEMENT PERMIT with plat ~~valid without expiration~~ site plan valid 60 mo.* ☑ *AUTHORIZATION TO CONSTRUCT* valid for period equal to IMPROVEMENT PERMIT–not to exceed 60 mo.

Owner / Applicant Signature: Bruce POA 5-4-12 Date 5-4-12 Installed by: Cothren & Son Grading

IMPROVEMENT PERMIT by: Justin Henderson REHS Date 5-1-12 OPERATION PERMIT by: Justin Henderson REHS Date 10-18-12

AUTHORIZATION TO CONSTRUCT by: Justin Henderson REHS Date 5-1-12 Existing System Inspected by: ____ REHS Date ____

YOU SHOULD CONTACT A LOCATOR SERVICE PRIOR TO ANY EXCAVATION

White Copy – Environmental Health YELLOW COPY (Final) Owner / Applicant PINK COPY (Initial) Owner / Applicant