IREDELL COUNTY HEALTH DEPARTMENT

Statesville Office (704) 878-5305 Mooresville Office (704) 660-3625 PERMIT # 203405

IMPROVEMENT PERMIT / AUTHORIZATION TO CONSTRUCT / OPERATION PERMIT / EXISTING SYSTEM

PIN # 4776817834

APPLICANT: Roy + Sonya Yagov APPLICANT ADDRESS: 125 Cactus Ln Statesville NC 28625

SITE ADDRESS: 125 Cactus Ln Statesville NC 28625 PHONE: 716-628-6282 ALT. PHONE: 716-628-1530

SITE DIRECTIONS: Mocksville Hwy E L on Swanntd R on Sagefield L on Cactus Ln

SUBDIVISION: Sagefield SECTION: 2 LOT # 12 LOT AREA: 0.499 DESIGN FLOW: 360 L.T.A.R.: EX

Septic Tank EX (gal) STB EX Date EX
Pump Tank N/A (gal) PT N/A Date N/A
Pump Make N/A Model N/A Serial # N/A
Nitrification Fields 1 # Lines 5 Linear Ft: EX
Trench Width EX Max. Trench Bottom Depth EX Gravel Depth N/A

☐ New System ☐ Repair ☐ Expansion System Type: I II (III) IV V VI
System Description: Existing
Repair System Description:
Maintenance Agreement Required: ☐ YES ☒ NO
☒ GRAVITY ☐ PRESSURE


☒ Residence No. Bedrooms 3
☐ Business No. Persons 6
☐ Other No. Employees
☐ Slab ☒ Crawl Space
☐ Basement w/plumbing ☐ Basement w/o plumbing

Water Supply: ☐ Private ☒ Public ☐ Community

Comments / Conditions: All parts of STS must be 55' from any part of deck.

INITIAL SITE SKETCH

AS BUILT SKETCH

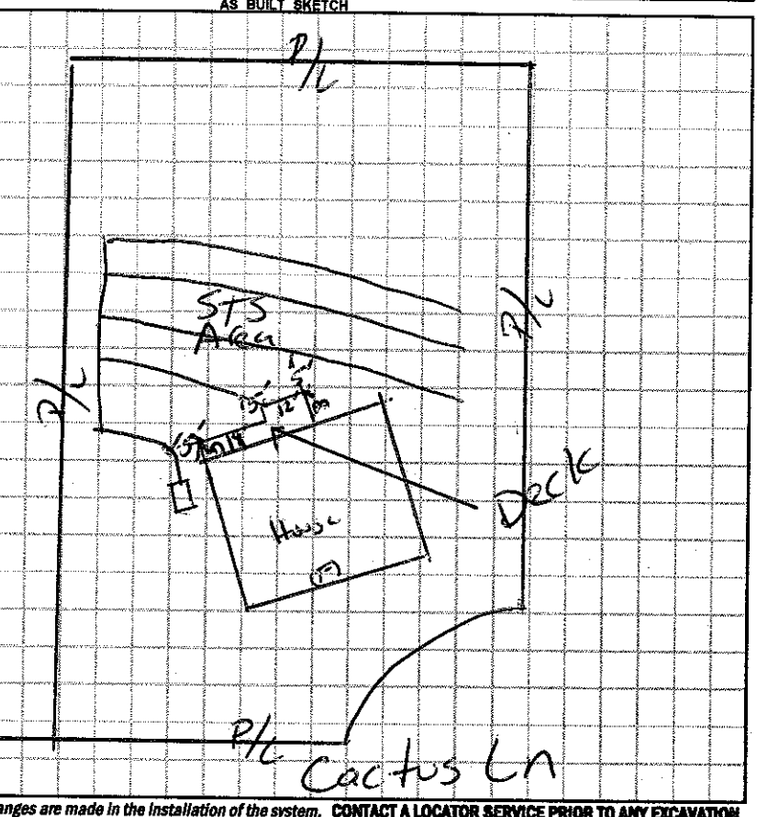

Permit can be suspended or revoked if any false information is supplied toward securing the permit / any unauthorized changes are made to the site / any unauthorized changes are made in the installation of the system. **CONTACT A LOCATOR SERVICE PRIOR TO ANY EXCAVATION**

☐ **IMPROVEMENT PERMIT** ***with plat*** *valid without expiration.* ☐ **IMPROVEMENT PERMIT** ***with site plan*** *valid for 60 mos.* ☐ **AUTHORIZATION TO CONSTRUCT** *valid for period equal to IMPROVEMENT PERMIT--not to exceed 60 mo.*

Owner / Applicant Signature: Sonya Yagov Date: Installed by:

IMPROVEMENT PERMIT by: Date: OPERATION PERMIT by: Date:

AUTHORIZATION TO CONSTRUCT by: Date: Existing System Inspected by: Date: 06/03/14

Health Dept. Copy - WHITE Applicant (Final Approval) - YELLOW Applicant (Conditional Approval) - PINK