IREDELL COUNTY HEALTH DEPARTMENT

STATESVILLE 704-878-5305 MOORESVILLE 704-664-5281

IMPROVEMENT PERMIT / AUTHORIZATION TO CONSTRUCT / OPERATION PERMIT / EXISTING SYSTEM INSPECTION

PERMIT # 159738 PIN # 4776-81-8863 DATE 10 February 10

OWNER or APPLICANT Bruce Porter PHONE: Business (704) 902-3134 Home:

~~OWNER or APPLICANT~~ Site ADDRESS 129 Cactus Ln. Statesville, N.C.

LOCATION / DIRECTIONS Hwy 64E TL Swannon Rd. TR Sagefield Dr. TL Cactus Ln. Go to end.

SUBDIVISION Sage Forest BLOCK / SECTION II LOT # 11 LOT AREA DESIGN FLOW 360 gpd L.T.A.R. 0.3 gpd/ft²

Septic Tank 1000 Gallons: STB 160 Date 3-17

Pump Tank Gallons: P T Date

Pump Make Model Serial #

Nitrification Field No Fields 1 No Lines 4 Linear Feet 300

Trench Width 36" Max. Trench Bottom Depth 36" Gravel Depth N/A

☑ New System ☐ Repair ☐ Expansion System Type I II (III) IV V VI

System Description: 25% Reduction System

Repair System Description: 25% Reduction System.

Maintenance Agreement Required ☐ YES ☑ NO

☑ GRAVITY ☐ PRESSURE

☑ Residence No. Bedrooms 3

☐ Business No. Persons

☐ Other No. Employees

☐ Slab ☑ Crawl Space


☐ Basement w/plumbing ☐ Basement w/o plumbing

Water Supply: ☐ Private ☑ Public ☐ Community


Comments / Conditions: Follow Contour / Clear trees as needed for system installation /

Comments / Conditions: Polylok filter for / ST Has marker.

INITIAL SITE SKETCH

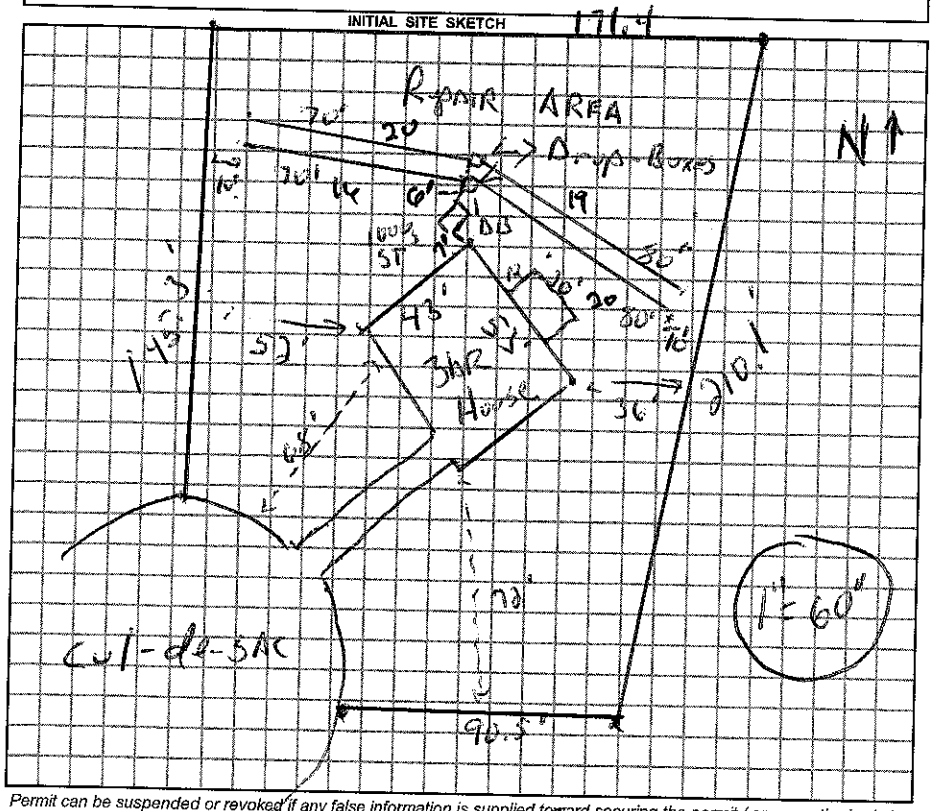

AS BUILT SKETCH

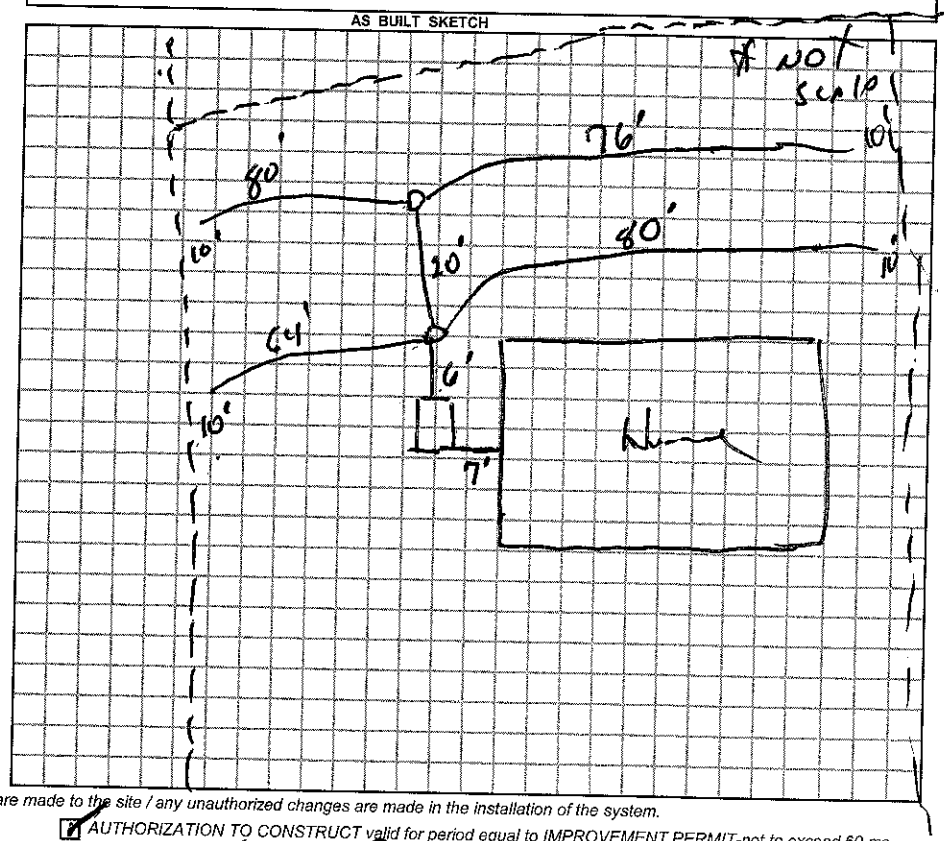

Permit can be suspended or revoked if any false information is supplied toward securing the permit / any unauthorized changes are made to the site / any unauthorized changes are made in the installation of the system.

☐ IMPROVEMENT PERMIT w / plat valid without expiration. ☑ IMPROVEMENT PERMIT w / site plan valid for 60 mos. ☑ AUTHORIZATION TO CONSTRUCT valid for period equal to IMPROVEMENT PERMIT-not to exceed 60 mo.

Owner / Applicant Signature: Bruce Porter Date 2-12-10

Improvement Permit by: R.S. Date 10 Feb. 10

Authorization to Construct by: R.S. Date 10 Feb 10

YOU SHOULD CONTACT A LOCATOR SERVICE PRIOR TO ANY EXCAVATION.

Installed by: Tommy Cathren

Operation Permit by: R.S. Date: 21 May 10

Existing System Inspected by: Date:

WHITE COPY Environmental Health YELLOW COPY (Final) Owner / Applicant PINK COPY (Initial) Owner / Applicant