IREDELL COUNTY HEALTH DEPARTMENT

STATESVILLE 704-878-5305 (C1) MOORESVILLE 704-664-5281

IMPROVEMENT PERMIT / AUTHORIZATION TO CONSTRUCT / OPERATION PERMIT / EXISTING SYSTEM INSPECTION

PERMIT# 100924 PIN# 4776-82-1065 DATE 6-26-01

OWNER OR CONTRACTOR D+D ENTERPRISES PHONE: Business 704-528-5808 Home

ADDRESS PO BOX 252 TROUTMAN NC 28166

LOCATION 64 E, (D) SWANN RD, (R) POPLAR LEAF, 1/2 WAY DWN ON RIGHT

SUBDIVISION 5TH CREEK EST BLOCK / SECTION LOT 16 LOT AREA .61 AC SITE CLASS PS DESIGN FLOW 360 L.T.A.R. .3

Septic Tank: 1000 Gallons: STB 1012 Date 4-1-02
Pump Tank: Gallons: PT Date
Pump Make: Model Serial No
Nitrification Field: No Fields 1 Square Feet 1200' Linear Feet 400'
No Lines 5 Trench Width 36" Max Trench Bottom Depth 36" Gravel Depth 12"

[X] New System [ ] Repair System Type: I (II) III IV V VI
System Description: CONV GRAV
Repair System Description: LP PANEL
Maintenance Agreement Required: [ ] Yes [X] No
[ ] Slab [X] Crawl Space [ ] Basement w/plumbing [ ] Basement wo/plumbing


[ ] House/Mod. Home No. Bedrooms 3
[ ] Mobile Home No. Bathrooms 2
[ ] Business No. Employees
[ ] Other

Water Supply: [ ] Individual [X] Public [ ] Community


Comments/Conditions: (1) INSTALL LINES ON CONTOUR (2) MAINTAIN SETBACKS (3) CALL FOR FLAGOUT

Comments/Conditions: (1) SYSTEM CHANGED TO 25% REDUCTION AT OWNERS REQUEST - PAID $130.00 BALANCE (2) SEPTIC TANK WITH MARKER INSTALLED USING "POLYLOK" FILTER

INITIAL SITE SKETCH

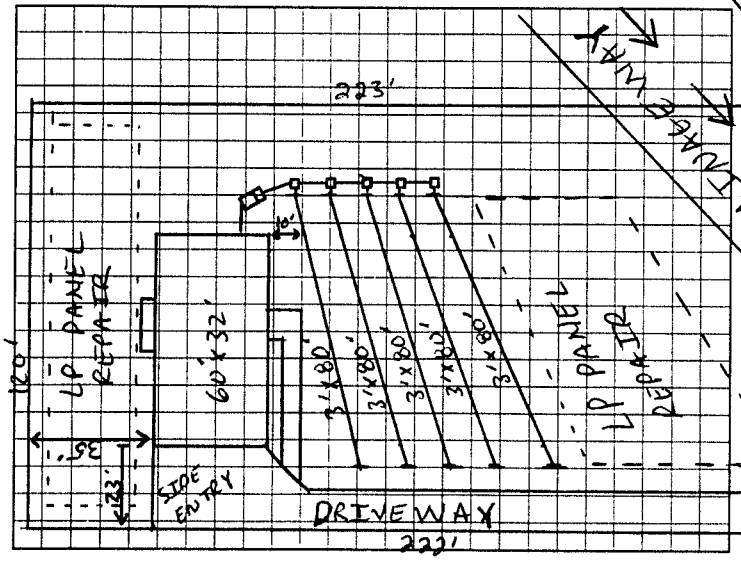

AS BUILT SKETCH

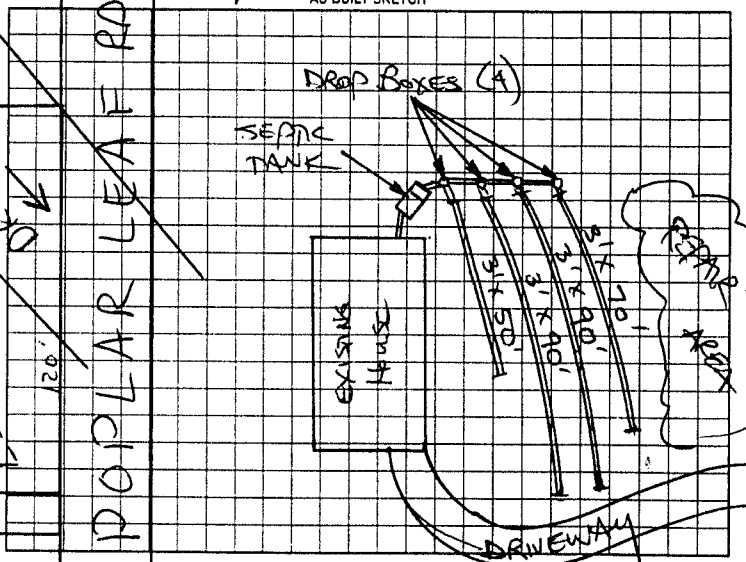

Permit can be suspended or revoked if any false information is supplied toward securing the permit/any unauthorized changes are made to the site/any unauthorized changes are made in the installation of the system. Improvement Permit with plat valid without expiration. Improvement Permit with site plan valid for sixty months. Authorization to Construct is valid for a period equal to that of Improvement Permit – not to exceed sixty months.

Signed: Agatha Neal Kelly date 7-30-01

Improvement Permit by: [signature] REHS date 6-26-01

Authorization to Construct by: [signature] REHS date 6-26-01

Installed by: TOMMY FRYE

Operation Permit by: STEVE HENDRICK date 10-14-02

Existing System Inspection by: date

HEALTH DEPT COPY WHITE OWNER COPY (FINAL) YELLOW OWNER COPY (INITIAL) PINK