IREDELL COUNTY HEALTH DEPARTMENT

STATESVILLE 704-878-5305 MOORESVILLE 704-664-5281 CI

IMPROVEMENT PERMIT / AUTHORIZATION TO CONSTRUCT / OPERATION PERMIT / EXISTING SYSTEM INSPECTION

PERMIT# 83174 PIN# 4776 82 2188 DATE 8-9-99

OWNER OR CONTRACTOR D+D Enterprizes PHONE: Business 528 6192 Home

ADDRESS PO BOX [redacted] 257 Troutman N.C.

LOCATION 64 E TO Swann TR before mc Allistry on New street on left

SUBDIVISION 5th creek Est BLOCK / SECTION LOT 6 LOT AREA .61 acres SITE CLASS PS DESIGN FLOW 360 L.T.A.R. .3

Septic Tank: 1000 Gallons; STB 1012 Date 09/16/01
Pump Tank: 1000 Gallons; PT 17 Date 1-15-02
Pump Make: GOULDS Model WE0511H Serial No. A0130589
Nitrification Field: No Fields 1 Square Feet 900 Linear Feet 300
No Lines 3 Trench Width 36" Max Trench Bottom Depth 34" Gravel Depth N/A

☑ New System ☐ Repair System Type: I, II, III, IV, V, VI
System Description: Gravity 25% Reduction
Repair System Description: ~~Elevated Sand Panel System~~
Maintenance Agreement Required: ☐ Yes ☑ No

☑ House/Mod. Home No. Bedrooms 3
☐ Mobile Home No. Bathrooms 2
☐ Business No. Employees
☐ Other


☑ Slab ☐ Crawl Space ☐ Basement w/plumbing ☐ Basement w/o plumbing

Water Supply: ☐ Individual ☑ Public ☐ Community

Comments/Conditions: See Attached Sheets for Pump T. set up Pressure manifold + clean out.


Comments/Conditions POLYLOK FILTER & MARKER V'D LINES & PRESSURE

INITIAL SITE SKETCH

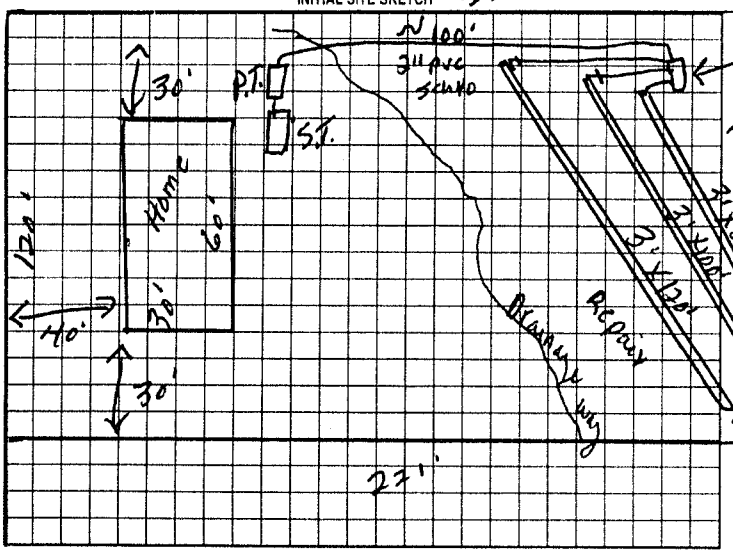

AS BUILT SKETCH

CHANGED TO 4x75' LINES ON PRESSURE MANIFOLD

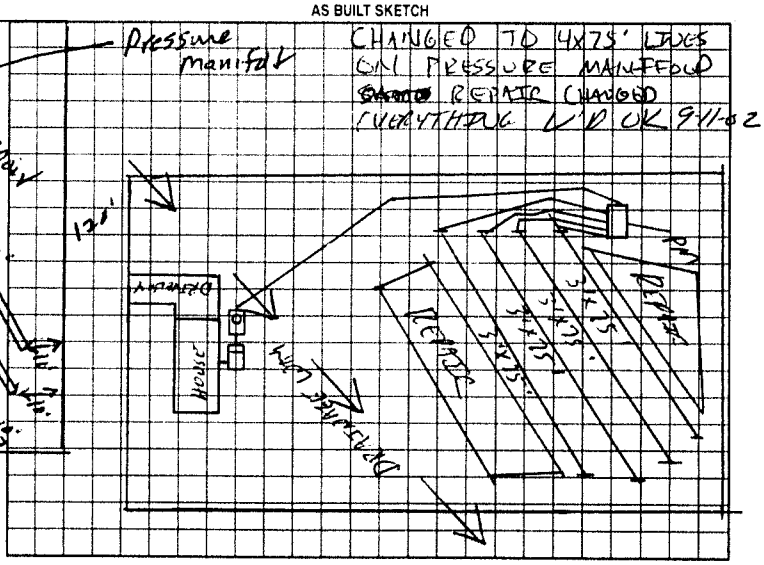

Permit can be suspended or revoked if any false information is supplied toward securing the permit/any unauthorized changes are made to the site/any unauthorized changes are made in the installation of the system. Improvement Permit with plat valid without expiration. Improvement Permit with site plan valid for sixty months. Authorization to Construct is valid for a period equal to that of Improvement Permit - not to exceed sixty months.

Signed: Joe Fode date 8/27/99 Installed by: Tommy Frye

Improvement Permit by: J.C. Moore date 8-9-99 Operation Permit by: [signature] date 05-11-02

Authorization to Construct by: J.C. Moore date 8-9-99 Existing System Inspection by: date

HEALTH DEPT. COPY: WHITE OWNER COPY (FINAL): YELLOW OWNER COPY (INITIAL): PINK