IREDELL COUNTY HEALTH DEPARTMENT

STATESVILLE 704-878-5305 MOORESVILLE 704-664-5281

IMPROVEMENT PERMIT / AUTHORIZATION TO CONSTRUCT / OPERATION PERMIT / EXISTING SYSTEM INSPECTION

PERMIT# 83175 PIN# 4776822188 DATE 8-9-99

OWNER OR CONTRACTOR D+D Enterprizes PHONE: Business 528 6192 Home

ADDRESS PO Box 252

LOCATION 64E TL Swann Rd TR First before mt Allister lot on left

SUBDIVISION Stincreek Est. BLOCK / SECTION LOT 7 LOT AREA .6 acres SITE CLASS PS DESIGN FLOW 360 L.T.A.R. .3

Septic Tank: 1000 Gallons; STB 1012 Date 11-2-00
Pump Tank: Gallons; PT Date
Pump Make: Model Serial No.
Nitrification Field: No Fields 1 Square Feet 900 Linear Feet 300
No Lines 3 Trench Width 36" Max Trench Bottom Depth 24" Gravel Depth N/A

☑ New System ☐ Repair System Type: I, II, III, IV, V, VI
System Description: Gravity 2SP Rotation
Repair System Description: " " " Shallow
Maintenance Agreement Required: ☐ Yes ☑ No
☐ Slab ☑ Crawl Space ☐ Basement w/plumbing ☐ Basement wo/plumbing


☑ House/Mod. Home No. Bedrooms 3
☐ Mobile Home No. Bathrooms 2
☐ Business No. Employees
☐ Other

Water Supply: ☐ Individual ☑ Public ☐ Community


Comments/Conditions:

Comments/Conditions ① SEPTIC TANK WITH MARKER INSTALLED USING "POLYLOK" FILTER
② SYSTEM ALTERED WITH PRIOR HEALTH DEPT. APPROVAL

INITIAL SITE SKETCH

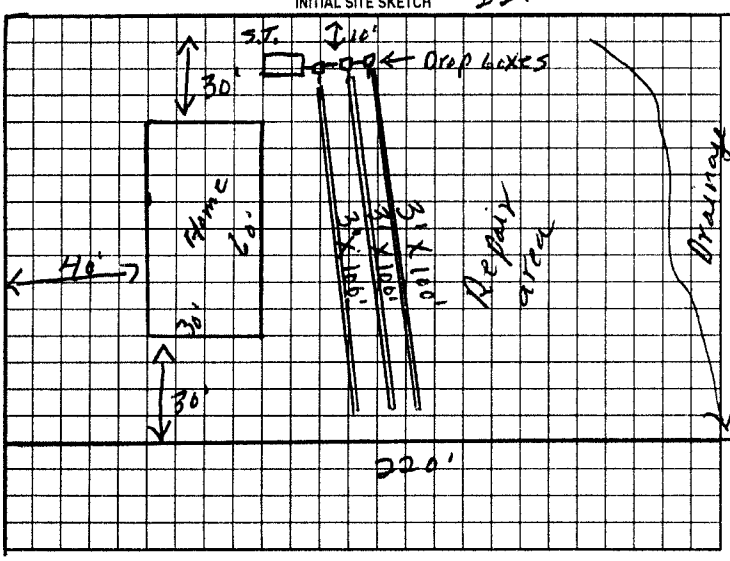

AS BUILT SKETCH

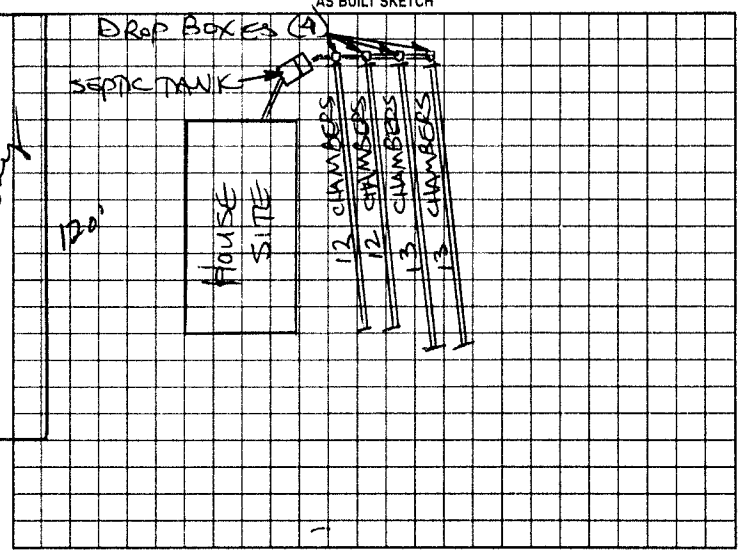

Permit can be suspended or revoked if any false information is supplied toward securing the permit/any unauthorized changes are made to the site/any unauthorized changes are made in the installation of the system. Improvement Permit with plat valid without expiration. Improvement Permit with site plan valid for sixty months. Authorization to Construct is valid for a period equal to that of Improvement Permit – not to exceed sixty months.

Signed: Jon York date 5/27/99 Installed by: TOMMY FRYE

Improvement Permit by: P. C. Moore date 8-9-99 Operation Permit by: STEVE HEDRICK date 2-20-01

Authorization to Construct by: P. C. Moore date 8-9-99 Existing System Inspection by: date

HEALTH DEPT COPY WHITE OWNER COPY (FINAL) YELLOW OWNER COPY (INITIAL) PINK