IREDELL COUNTY HEALTH DEPARTMENT

STATESVILLE 704-878-5305 MOORESVILLE 704-664-5281

IMPROVEMENT PERMIT / AUTHORIZATION TO CONSTRUCT / OPERATION PERMIT / EXISTING SYSTEM INSPECTION

DATE 11-20-00

PERMIT# 90422 PIN# 4776 52 2188

OWNER OR CONTRACTOR D+D Enterprises PHONE: Business 528 6192 Home

ADDRESS PO Box 252 Troutman NC. 28166

LOCATION Lot E Th Swann Rd. TR Poplar left at end on left.

SUBDIVISION Gathcock Est. BLOCK / SECTION LOT 9 LOT AREA .85 acres SITE CLASS. PS DESIGN FLOW 360 L.T.A.R. .3

Septic Tank: 1000 Gallons: STB 799 Date 3-2-01
Pump Tank: Gallons: PT Date
Pump Make: Model Serial No.
Notification Field: No Fields 1 Square Feet 1200 Linear Feet 400
No Lines 3 Trench Width 36" Max Trench Bottom Depth 24" Gravel Depth 12"

☑ New System ☐ Repair System Type: I, II, III, IV, V, VI
System Description: Conv. Gravity (shallow)
Repair System Description:
Maintenance Agreement Required: ☐ Yes ☑ No

☑ House/Mod. Home No. Bedrooms 3
☐ Mobile Home No. Bathrooms 2
☐ Business No. Employees
☐ Other


☐ Slab ☐ Crawl Space ☐ Basement w/plumbing ☐ Basement w/o plumbing

Water Supply: ☐ Individual ☐ Public ☐ Community

Comments/Conditions: 217'

Comments/Conditions: SYSTEM INSTALLED AS SHOWN WITH MODEL POLYLOK FILTER

INITIAL SITE SKETCH

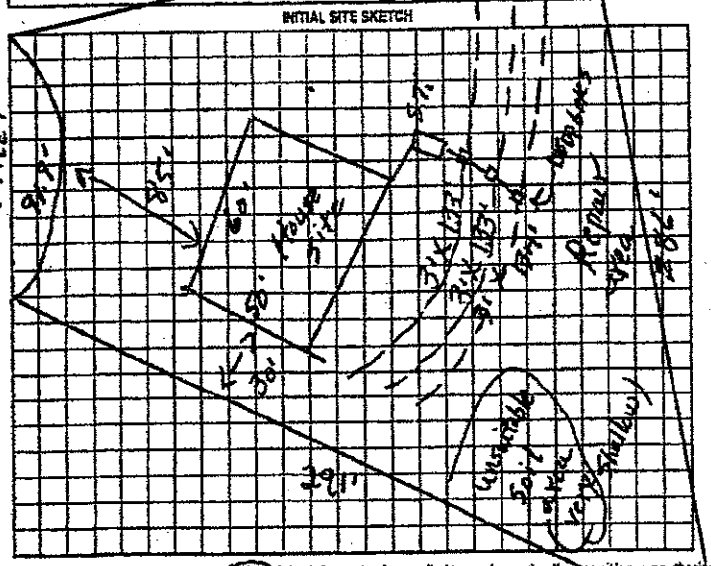

AS BUILT SKETCH

Permit can be suspended or revoked if any false information is supplied toward securing the permit/any unauthorized changes are made to the site/any unauthorized changes are made in the installation of the system. Improvement Permit with site plan valid for sixty months. Authorization to Construct is valid for a period equal to that of Improvement Permit – not to exceed sixty months.

Signed: date Installed by: TOMMY FRYE

Improvement Permit by: E.C. Moore date 11-20-00 Operation Permit by: EHS date 5-4-01

Authorization to Construct by: E.C. Moore date 11-20-00 Existing System Inspection by: date

HEALTH DEPT. COPY: WHITE OWNER COPY (FINAL): YELLOW OWNER COPY (INITIAL): PINK