IREDELL COUNTY HEALTH DEPARTMENT

STATESVILLE 704-878-5305 MOORESVILLE 704-664-5281

IMPROVEMENT PERMIT / AUTHORIZATION TO CONSTRUCT / OPERATION PERMIT / EXISTING SYSTEM INSPECTION

PERMIT# 75091 PIN# 477683 7617 DATE 7-12-99

OWNER OR CONTRACTOR Ted Benbow PHONE: Business 878 9661 Home

ADDRESS 216 Harvill St. Statesville

LOCATION 64E to Swann Rd TR Taxidermy Turn on Getsoo (Bugle Dear Ln) Court 152 Getsoo

SUBDIVISION Ted Benbow Property BLOCK / SECTION LOT 1 LOT AREA 1.2 SITE CLASS PS DESIGN FLOW 480 L.T.A.R. .3

Septic Tank: 1000 Gallons; STB 760 Date 6-1-99
Pump Tank: Gallons; PT Date
Pump Make: Model Serial No.
Nitrification Field: No Fields 1 Square Feet 1600 Linear Feet 533
No Lines 4 Trench Width 36" Max Trench Bottom Depth 36" Gravel Depth 12"

✓ New System ☐ Repair System Type: I. II. III. IV. V. VI
System Description: Conv. Gravity
Repair System Description:
Maintenance Agreement Required: ☐ Yes ✓ No


✓ House/Mod. Home No. Bedrooms 4
✓ Mobile Home No. Bathrooms 2
☐ Business No. Employees
☐ Other
☐ Slab ☐ Crawl Space ☐ Basement w/plumbing ☐ Basement wo/plumbing

Water Supply: ✓ Individual ☐ Public ☐ Community


Comments/Conditions: Permit Replaces Issued 7-30-98 going to 4 BR unit.

Comments/Conditions

INITIAL SITE SKETCH

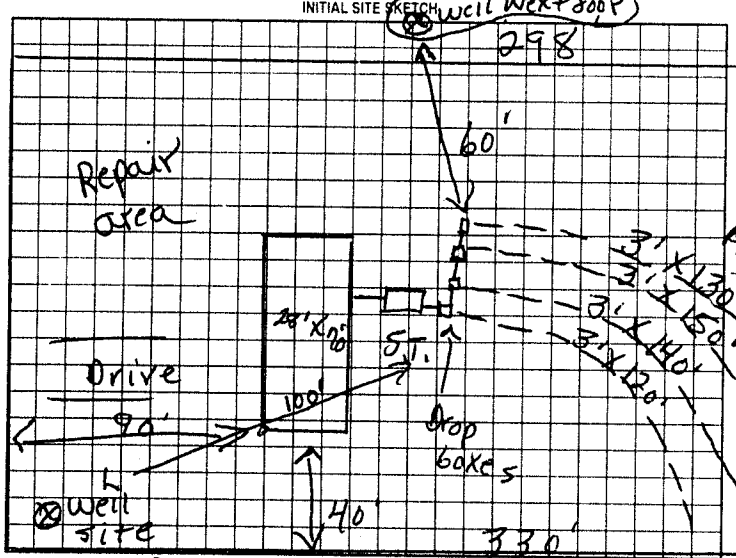

AS BUILT SKETCH

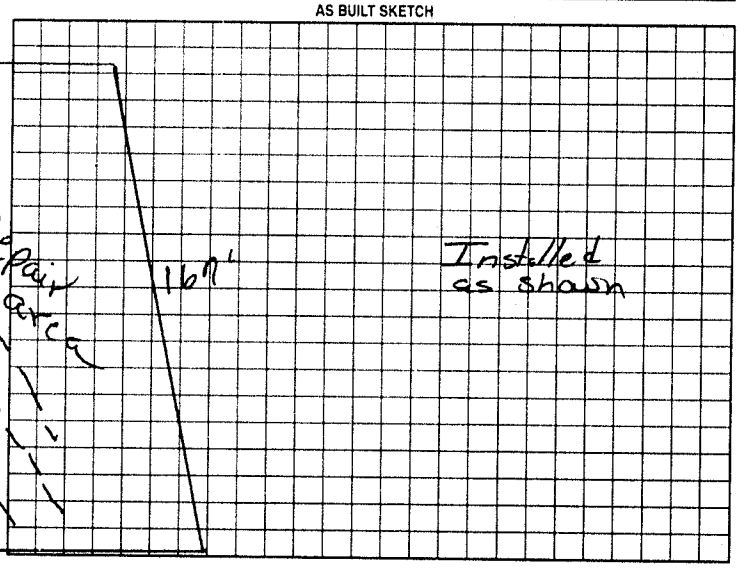

Permit can be suspended or revoked if any false information is supplied toward securing the permit/any unauthorized changes are made to the site/any unauthorized changes are made in the installation of the system. Improvement Permit with plat valid without expiration. Improvement Permit with site plan valid for sixty months. Authorization to Construct is valid for a period equal to that of Improvement Permit -- not to exceed sixty months.

Signed: X Julia Burk date Installed by: Shane Jarrett

Improvement Permit by: P.C. moore date 7-12-99 Operation Permit by: Mat Catz RS date 7-30-99

Authorization to Construct by: P.C. moore date 7-12-99 Existing System Inspection by: date

HEALTH DEPT COPY WHITE OWNER COPY (FINAL) YELLOW OWNER COPY (INITIAL) PINK