THIS PERMIT REPLACES PREVIOUSLY ISSUED PERMIT ON 6-28-99. 10:00

IREDELL COUNTY HEALTH DEPARTMENT

STATESVILLE 704-878-5305 MOORESVILLE 704-664-5281

IMPROVEMENT PERMIT / AUTHORIZATION TO CONSTRUCT / OPERATION PERMIT / EXISTING SYSTEM INSPECTION

PERMIT# 113224 PIN# 4777-04-3149 DATE 6-19-03

OWNER OR CONTRACTOR JAMES W. SIGMON PHONE: Business 704 880-2667 Home

ADDRESS P.O. BOX 2152 STATESVILLE, NC 28687

LOCATION 64 EAST, (L) OLD MOCKSVILLE, (R) COOL SPRINGS RD, ON RT PAST OLD WHITEHOUSE 2 1/4 mile

SUBDIVISION BLOCK / SECTION LOT LOT AREA 10.00AC SITE CLASS. PS DESIGN FLOW 360 L.T.A.R. .5

Septic Tank: 1000 Gallons; STB 1012 Date 4-6-03
Pump Tank: Gallons; PT Date
Pump Make: Model Serial No.
Nitrification Field: No Fields 1 Square Feet 1200' Linear Feet 400'
No Lines 4X100' Trench Width 36" Max Trench Bottom Depth 36" Gravel Depth 12"

☒ New System ☐ Repair System Type: I (II) III, IV, V, VI
System Description: CONV 6" EAV
Repair System Description: SAME
Maintenance Agreement Required: ☐ Yes ☒ No

☒ House/Mod. Home No. Bedrooms 3
☐ Mobile Home No. Bathrooms 2
☐ Business No. Employees
☐ Other


☐ Slab ☒ Crawl Space ☐ Basement w/plumbing ☐ Basement wo/plumbing

Water Supply: ☐ Individual ☒ Public ☐ Community


Comments:/Conditions: (1) CALL PRIOR TO INSTALLATION FOR FLAGOUT (2) INSTALL LINES ON CONTOUR. (3) MAINTAIN SETBACKS (4) HOUSE IS ONLY 2 BEDROOM. SIZING SYSTEM FOR A 3 BEDROOM

Comments:/Conditions: TUFF TITE FILTER & MARKER CALLED PROPERTY OWNER & SYSTEM IS GREATER THAN 10' OFF P/L.

INITIAL SITE SKETCH "NOT TO SCALE"

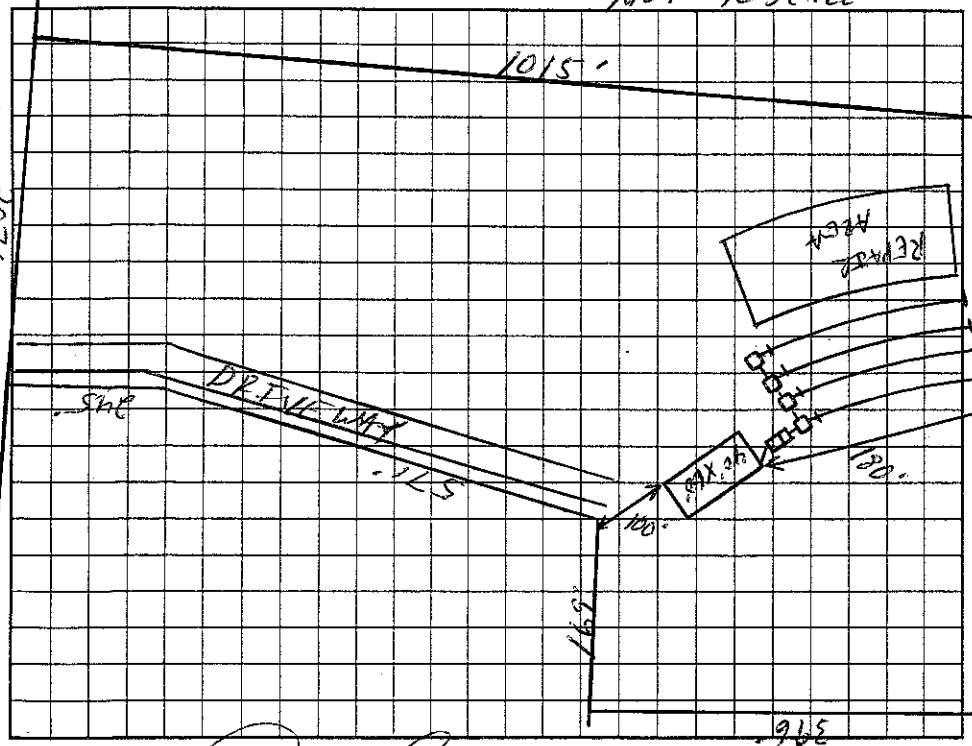

AS BUILT SKETCH

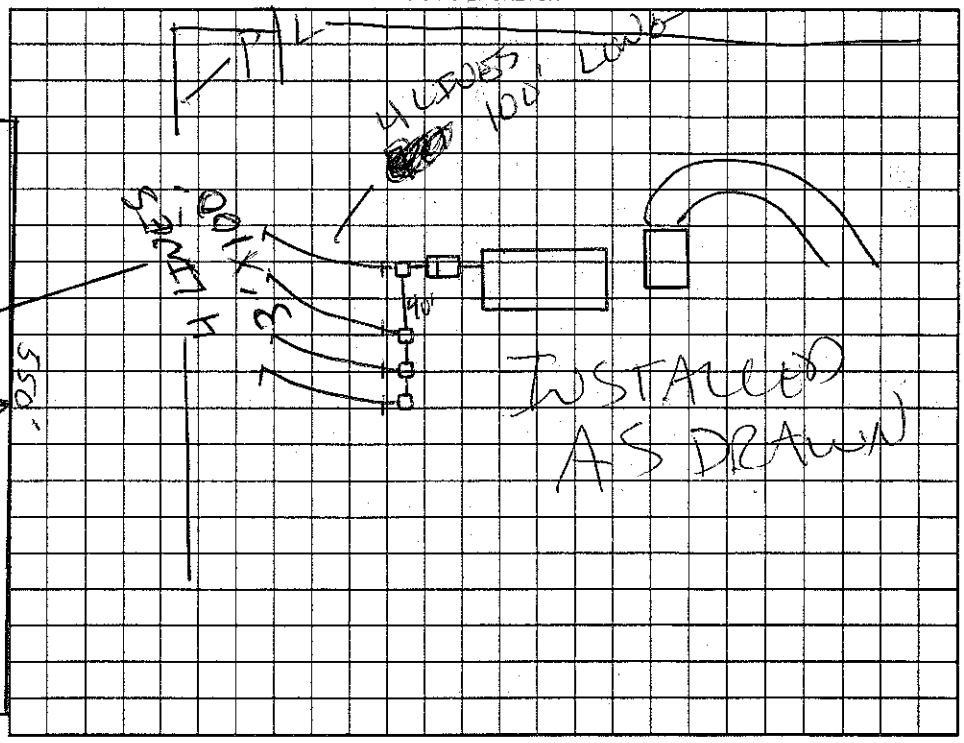

Permit can be suspended or revoked if any false information is supplied toward securing the permit/any unauthorized changes are made to the site/any unauthorized changes are made in the installation of the system. Improvement Permit with plat valid without expiration. Improvement Permit with site plan valid for sixty months. Authorization to Construct is valid for a period equal to that of Improvement Permit – not to exceed sixty months.

Signed: date 6/20/03 Installed by: A-1 BACKHOE

Improvement Permit by: date 6-19-03 Operation Permit by: date 10-17-03

Authorization to Construct by: date 6-19-03 Existing System Inspection by: date

HEALTH DEPT. COPY: WHITE OWNER COPY (FINAL): YELLOW OWNER COPY (INITIAL): PINK