IREDELL COUNTY HEALTH DEPARTMENT

STATESVILLE 704-878-5305 MOORESVILLE 704-664-5281

IMPROVEMENT PERMIT / AUTHORIZATION TO CONSTRUCT / OPERATION PERMIT / EXISTING SYSTEM INSPECTION

PERMIT# 094732 PIN# 4777 09 1257 DATE 3-20-01

OWNER OR CONTRACTOR JOE & BONNIE KECK PHONE: Business c/o Home (704) 528-3320

ADDRESS 181 PIERCE BLUFF DRIVE, STATESVILLE, NC 28625

LOCATION OLD MOCKSVILLE ROAD NE, TL PIERCE BLUFF DRIVE, 2ND DWELLING ON LEFT

SUBDIVISION _____ BLOCK / SECTION _____ LOT _____ LOT AREA 1.09 ACRES SITE CLASS PS DESIGN FLOW 480 L.T.A.R. 0.30 GPD/FT

Septic Tank: 1000 Gallons: STB 1012 Date 2-7-01
Pump Tank: _____ Gallons: PT _____ Date _____
Pump Make: _____ Model _____ Serial No. _____
Nitrification Field: No Fields 1 Square Feet 900 Linear Feet 300
No Lines FOUR Trench Width 36" Max Trench Bottom Depth 36" Gravel Depth 12"

☑ New System ☐ Repair System Type: I (II) III. IV. V. VI
System Description: CONVENTIONAL GRAVITY
Repair System Description: CONVENTIONAL GRAVITY
Maintenance Agreement Required: ☐ Yes ☑ No
☐ Slab ☑ Crawl Space ☐ Basement w/plumbing ☐ Basement wo/plumbing


☑ House/Mod. Home ☐ Mobile Home ☐ Business ☐ Other
No. Bedrooms 4
No. Bathrooms 2
No. Employees _____

Water Supply: ☑ Individual ☐ Public ☐ Community
WELL

Comments/Conditions: ① EXPAND SYSTEM BY ADDING NEW SEPTIC TANK AND LINES AS SHOWN, FEEDING EXISTING SYSTEM THRU FLOW DIVIDER TEE ② LOCATE ALL UTILITIES BEFORE DIGGING

Comments/Conditions: SEPTIC TANK WITH MARKER INSTALLED USING "POLY-LOK" FILTER

INITIAL SITE SKETCH

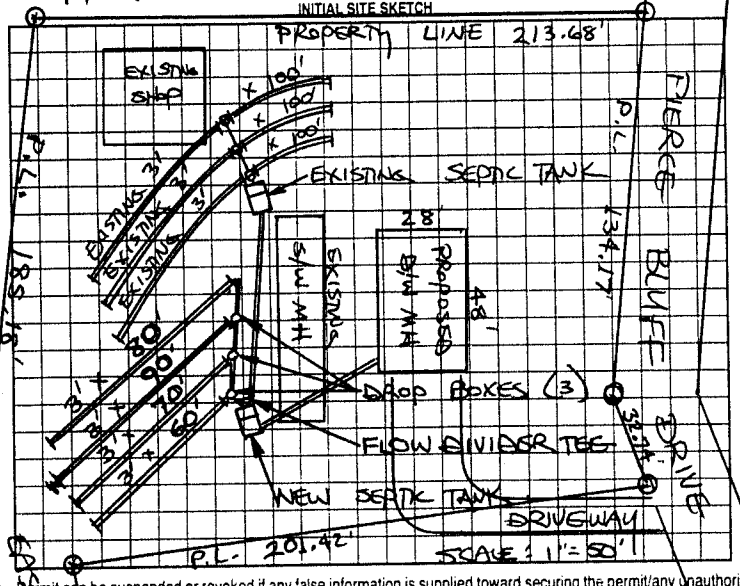

AS BUILT SKETCH

SYSTEM EXPANDED ACCORDING TO INITIAL SITE SKETCH.

Permit can be suspended or revoked if any false information is supplied toward securing the permit/any unauthorized changes are made to the site/any unauthorized changes are made in the installation of the system. Improvement Permit with plat valid without expiration. Improvement Permit with site plan valid for sixty months. Authorization to Construct is valid for a period equal to that of Improvement Permit – not to exceed sixty months.

Signed: _____ date 3-21-01 Installed by: A-1 BACKHOE

Improvement Permit by: STEVE HEDRICK date 3-20-01 Operation Permit by: STEVE HEDRICK date 4-4-01

Authorization to Construct by: STEVE HEDRICK date 3-20-01 Existing System Inspection by: _____ date _____

HEALTH DEPT COPY WHITE OWNER COPY (FINAL) YELLOW OWNER COPY (INITIAL) PINK