IREDELL COUNTY HEALTH DEPARTMENT

IMPROVEMENT PERMIT / AUTHORIZATION TO CONSTRUCT / OPERATION PERMIT / EXISTING SYSTEM INSPECTION

STATESVILLE 704-878-5305 MOORESVILLE 704-664-5281

PERMIT# 20939 PIN# 4777127850 DATE 3-7-07

OWNER OR APPLICANT Jeffrey and Angela Wood PHONE: Business _____ Home 704-878-5416

ADDRESS 45 Beechwood Farm RD Statesville 28625

LOCATION Old Mocksville (R) Chonnet (L) Beechwood almost at end

SUBDIVISION James L. Craven BLOCK / SECTION _____ LOT 2 LOT AREA 1.538 SITE CLASS. 75 DESIGN FLOW 360 L.T.A.R. 3

Septic Tank: 1000 Gallons; STB 1000 Date 8-23-04

Pump Tank: 1000 Gallons; PT 24 Date 8-15-04

Pump Make: _____ Model PVP 95-B Serial No. _____

Nitrification Field: No Fields ___ Square Feet 420 Linear Feet 300

No Lines 3 Trench Width 36" Max Trench Bottom Depth 35" Gravel Depth _____

☐ New System ☐ Repair ☐ Expansion System Type: I II III IV V VI

System Description: Existing B

Repair System Description: _____

Maintenance Agreement Required: ☐ Yes ☐ No

☑ House/Mod. Home No. Bedrooms 3

☐ Mobile Home No. Persons ___

☐ Business No. Employees ___

☐ Other _____

Water Supply: ☑ Individual ☐ Public ☐ Community


☐ Gravity ☐ Pressure ☐ Slab ☐ Crawl Space ☐ Basement w/plumbing ☐ Basement wo/plumbing

Comments/Conditions:

Comments/Conditions:

INITIAL SITE SKETCH

AS BUILT SKETCH

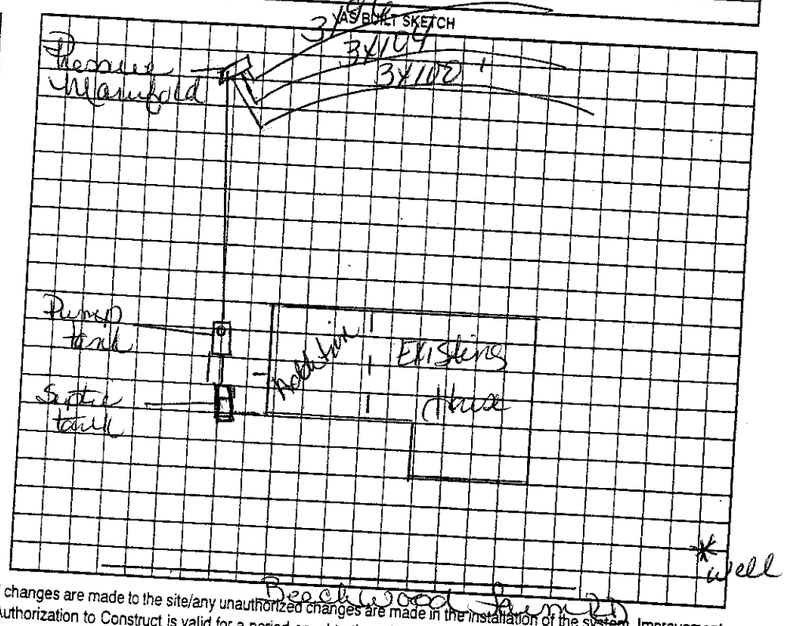

Permit can be suspended or revoked if any false information is supplied toward securing the permit/any unauthorized changes are made to the site/any unauthorized changes are made in the installation of the system. Improvement Permit with plat valid without expiration ☐ Improvement Permit with site plan valid for sixty months ☐ Authorization to Construct is valid for a period equal to that of Improvement Permit – not to exceed sixty months.

Signed: _____ date _____

Improvement Permit by: _____ date _____

Authorization to Construct by: _____ date _____

Installed by: _____

Operation Permit by: _____ date _____

Existing System Inspection by: Keith Cook date 3-7-07

HEALTH DEPT. COPY: WHITE OWNER COPY (FINAL): YELLOW OWNER COPY (INITIAL): PINK