* Repair

IREDELL COUNTY HEALTH DEPARTMENT

STATESVILLE 704-878-5305 MOORESVILLE 704-664-5281

IMPROVEMENT PERMIT / AUTHORIZATION TO CONSTRUCT / OPERATION PERMIT / EXISTING SYSTEM INSPECTION

PERMIT # Repair PIN # 4777-37-5587 DATE 23 November 09

OWNER or APPLICANT Maxine Wilke / Reida Allen PHONE: ~~Business~~ Cell (704) 902-2564 Home:

OWNER or APPLICANT ADDRESS 1696 Old Mocksville Rd. Statesville, N.C.

LOCATION / DIRECTIONS Hwy 64 E TL Old Mocksville Rd. 1696 on Rt.

SUBDIVISION BLOCK / SECTION LOT # LOT AREA 150 Ac. DESIGN FLOW 360 g/d L.T.A.R. 0.3 g/FF/d

Septic Tank	Exist.	Gallons: STB		Date			
Pump Tank		Gallons: P T		Date			
Pump Make		Model		Serial #			
Nitrification Field	No Fields 1	No Lines 5	Linear Feet 300				
Trench Width	36"	Max. Trench Bottom Depth	36"	Gravel Depth	NA		

☐ New System ☑ Repair ☐ Expansion System Type I II (III) IV V VI

System Description: 25% Reduction

Repair System Description: 25% Reduction

Maintenance Agreement Required ☐ YES ☑ NO

☑ GRAVITY ☐ PRESSURE


☑ Residence No. Bedrooms 3 ☐ Business No. Persons ☐ Other No. Employees ☐ Slab ☑ Crawl Space ☐ Basement w/plumbing ☐ Basement w/o plumbing

Water Supply: ☑ Private ☐ Public ☐ Community

Comments / Conditions: Keep out of plowed Area / Follow contour

Comments / Conditions

INITIAL SITE SKETCH

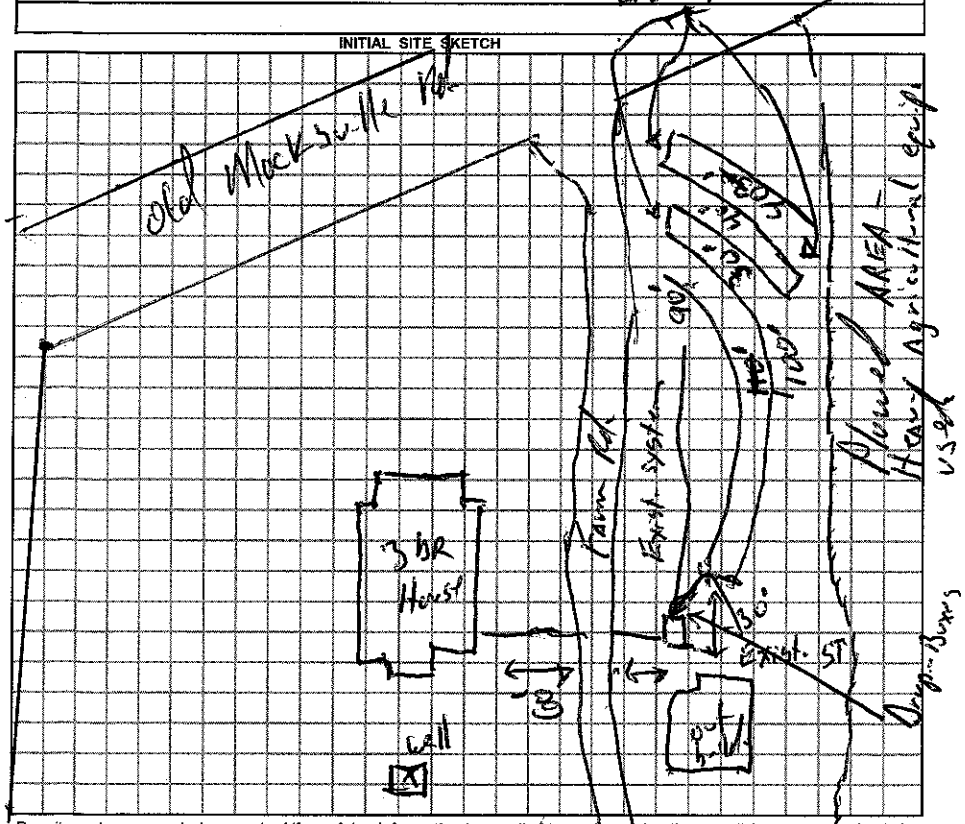

AS BUILT SKETCH

Installed As shown

Permit can be suspended or revoked if any false information is supplied toward securing the permit / any unauthorized changes are made to the site / any unauthorized changes are made in the installation of the system.

☐ *IMPROVEMENT PERMIT w / plat valid without expiration.* ☑ *IMPROVEMENT PERMIT w / site plan valid for 60 mos.* ☑ *AUTHORIZATION TO CONSTRUCT valid for period equal to IMPROVEMENT PERMIT-not to exceed 60 mo.*

Owner / Applicant Signature: Reida Allen Date 11-30-09

Improvement Permit by: [signature], R.S. Date 23 Nov. 09

Authorization to Construct by: [signature], R.S. Date 23 Nov. 09

Installed by: Bryant Gallahan

Operation Permit by: [signature], R.S. Date: 8 December 09

Existing System Inspected by: Date:

YOU SHOULD CONTACT A LOCATOR SERVICE PRIOR TO ANY EXCAVATION.

WHITE COPY Environmental Health YELLOW COPY (Final) Owner / Applicant PINK COPY (Initial) Owner / Applicant