IREDELL COUNTY HEALTH DEPARTMENT

Statesville Phone TR 3-7271 Mooresville Phone NO 3-1271

PERMIT TO INSTALL SEPTIC TANK

Permit No. 242 Permit Date 10-13 1971

Owner HARVY CRANFIELD Address Statsville

Installed By RAYMOND ADAMS Address TAYLORSVILLE


Location of Property NEXT TO CORNER LOT OF OLD MOXVILLE HWY AND 2162

| Tank | | Capacity | | Length of Lines | | Fixtures | |
|---|---|---|---|---|---|---|---|
| Block | ( ) | 1000 | (✓) | 225' | (✓) | No. of Baths | ( ) |
| Precast | (✓) | 1250 | ( ) | 250' | ( ) | Dishwasher | ( ) |
| | | 1500 | ( ) | Other | | Garbage Grdr. | ( ) |
| | | Other | | | | Other | |

NOTIFY HEALTH DEPARTMENT AT LEAST EIGHT HOURS BEFORE TANK IS TO BE INSPECTED.

Final Inspection 10-13-71 Approved ( ) Disapproved ( )

Remarks * Not Checked

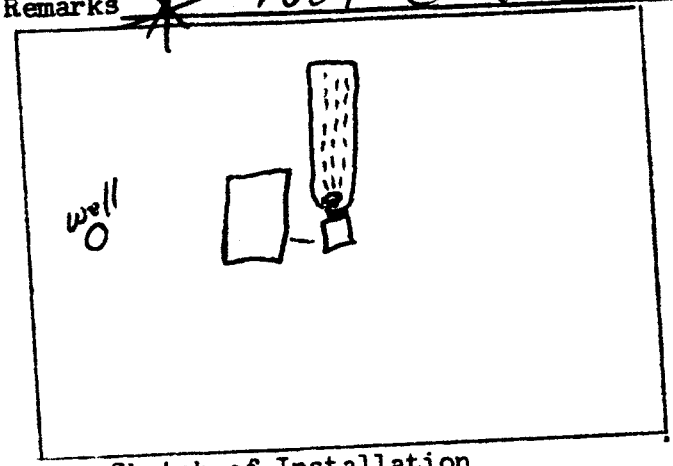


Sketch of Installation

C. S. H.

Sanitarian