IREDELL COUNTY HEALTH DEPARTMENT

Statesville Phone TR 3-7271 Mooresville Phone NO 3-1271

PERMIT TO INSTALL SEPTIC TANK

Permit No. 242 Permit Date 10 - 12 1971

Owner HARVY CRAWFIELD Address STATESVILLE

Installed By RAYMOND HOMS Address TAYLORSVILLE


Location of Property ON CORNER OF old MOORVILLE HW 2ND HWY 2162 CORNER 204

| Tank | | Capacity | | Length of Lines | | Fixtures | |
|---|---|---|---|---|---|---|---|
| Block | ( ) | 1000 | (✓) | 225' | (✓) | No. of Baths | (1½) |
| Precast | (✓) | 1250 | ( ) | 250' | ( ) | Dishwasher | ( ) |
| | | 1500 | ( ) | Other | | Garbage Grdr. | ( ) |
| | | Other | | | | Other | |

NOTIFY HEALTH DEPARTMENT AT LEAST EIGHT HOURS BEFORE TANK IS TO BE INSPECTED.

Final Inspection 10 - 13 1971 Approved ( ) Disapproved ( )

Remarks: X Not checked

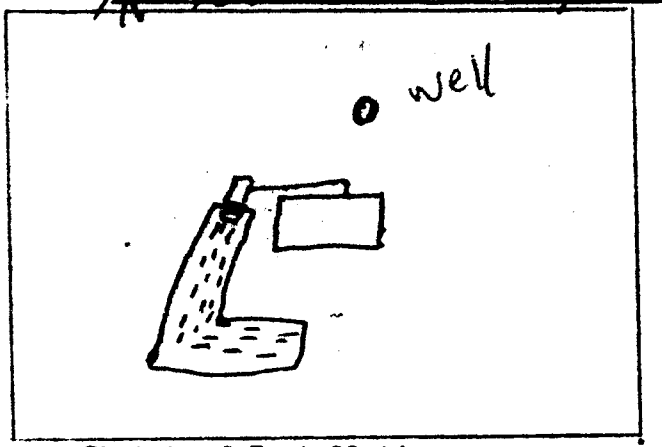


Sketch of Installation

C.S.H.

Sanitarian