IREDELL COUNTY HEALTH DEPARTMENT

STATESVILLE 704-878-5305 (C\) MOORESVILLE 704-664-5281

IMPROVEMENT PERMIT / AUTHORIZATION TO CONSTRUCT / OPERATION PERMIT / EXISTING SYSTEM INSPECTION

PERMIT# 145709 PIN# 4777582607 1770 DATE 10/25/07

OWNER OR APPLICANT Dale & Nina Flinchum PHONE: Business 336-753-6120 Home 704 872 9420

ADDRESS White Oak Branch

LOCATION 140E to Davis Hospital Exit to Old Mocksville Hwy, (R) on White Oak Branch, property on R~0.20 MILE

SUBDIVISION n/a BLOCK / SECTION ____ LOT 37 LOT AREA 2.65 SITE CLASS: PS DESIGN FLOW 360 L.T.A.R. .25

Septic Tank: 1000 Gallons: STB 794 Date 5-23-08

Pump Tank: ____ Gallons: PT ____ Date ____

Pump Make: ____ Model ____ Serial No. ____

Nitrification Field: No Fields 1 Square Feet 1440 Linear Feet 360

No Lines 3 Trench Width 36 Max Trench Bottom Depth 36"

☒ New System ☐ Repair ☐ Expansion System Type: I II III IV V VI

System Description: 25% Reduction Gravity

Repair System Description: 25% Reduction Gravity Pump

Maintenance Agreement Required: ☐ Yes ☒ No

Gravel Depth N/A ☒ Gravity ☐ Pressure

☒ House/Mod. Home No. Bedrooms 3

☐ Mobile Home No. Persons ____

☐ Business No. Employees ____

☐ Other ____


Water Supply: ☒ Individual ☐ Public ☐ Community

☐ Slab ☒ Crawl Space ☐ Basement w/plumbing ☐ Basement wo/plumbing


Comments:/Conditions:

Comments:/Conditions: SEPTIC TANK WITH MARKER INSTALLED USING RED "Poly Ok" FILTER SYSTEM INSTALLED AS SHOWN

INITIAL SITE SKETCH

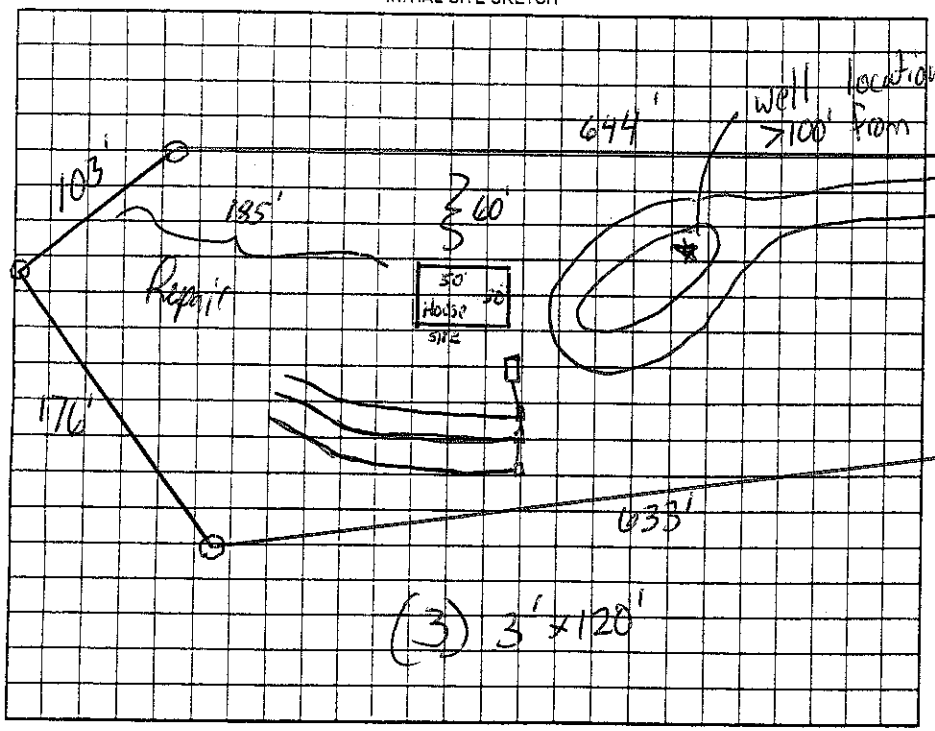

AS BUILT SKETCH

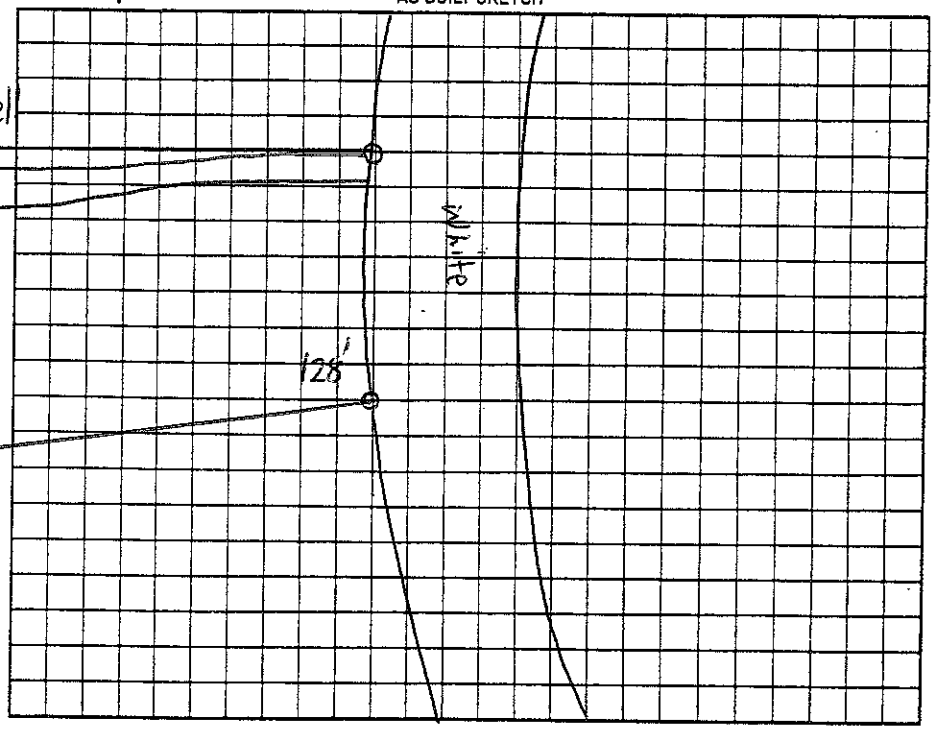

Permit can be suspended or revoked if any false information is supplied toward securing the permit/any unauthorized changes are made to the site/any unauthorized changes are made in the installation of the system. Improvement Permit with plat valid without expiration ☐ Improvement Permit with site plan valid for sixty months ☒ Authorization to Construct is valid for a period equal to that of Improvement Permit – not to exceed sixty months.

Signed: Nina M. Flinchum date ____

Improvement Permit by: James Orr date 10/25/07

Authorization to Construct by: James Orr date 10/25/07

Installed by: TUCKER'S HAULING & GRADING

Operation Permit by: STEVE HENDRICK date 7-22-08

Existing System Inspection by: ____ date ____

HEALTH DEPT. COPY: WHITE OWNER COPY (FINAL): YELLOW OWNER COPY (INITIAL): PINK