IREDELL COUNTY HEALTH DEPARTMENT

STATESVILLE 704-878-5305 MOORESVILLE 704-664-5281

IMPROVEMENT PERMIT / AUTHORIZATION TO CONSTRUCT / OPERATION PERMIT / EXISTING SYSTEM INSPECTION

PERMIT# 92178 PIN# 4777 58 1916 DATE 10/10/00

OWNER OR CONTRACTOR RONALD COTTLEMAN PHONE: Business 873-2547 Home

ADDRESS 1921 OLD WILKESBORO RD STATESVILLE NC 28625

LOCATION OLD MOCKSVILLE RD. TR WHITE OAK BRANCH. ON RT

SUBDIVISION WHITE OAK BRANCH BLOCK / SECTION LOT 1 LOT AREA .74 AC SITE CLASS. PS DESIGN FLOW 360GPD L.T.A.R. .30 FO/FT2

Septic Tank: 1000 Gallons: STB 1012 Date 8-24-00
Pump Tank: Gallons: PT Date
Pump Make: Model Serial No.
Nitrification Field: No Fields 1 Square Feet 400 Linear Feet 200
No Lines 4 @ 50' Trench Width 24" Max Trench Bottom Depth 36"


☑ New System ☐ Repair System Type: I, II, III, IV, V, VI
System Description: GRAVITY PANEL
Repair System Description: PUMP PANEL
Maintenance Agreement Required: ☐ Yes ☑ No

☑ House/Mod. Home No. Bedrooms 3
☐ Mobile Home No. Bathrooms 3
☐ Business No. Employees
☐ Other

☐ Slab ☑ Crawl Space ☐ Basement w/plumbing ☐ Basement wo/plumbing


Water Supply: ☑ Individual ☐ Public ☐ Community

Comments/Conditions: 1" = 60'

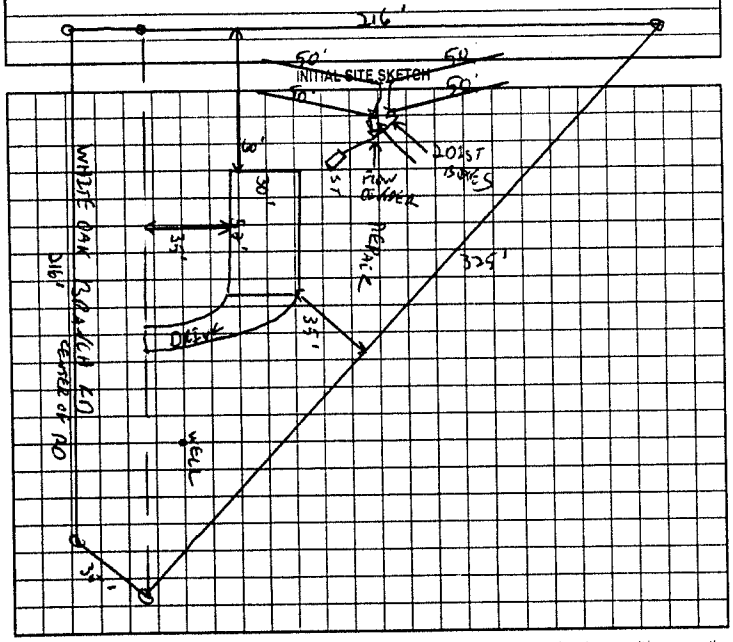

Comments/Conditions: Installed as shown

AS BUILT SKETCH

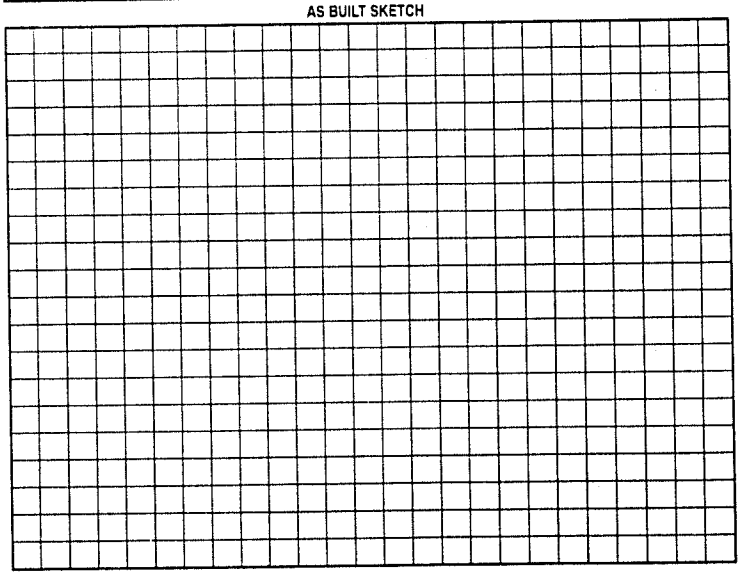

Permit can be suspended or revoked if any false information is supplied toward securing the permit/any unauthorized changes are made to the site/any unauthorized changes are made in the installation of the system. Improvement Permit with plat valid without expiration. Improvement Permit with site plan valid for sixty months. Authorization to Construct is valid for a period equal to that of Improvement Permit – not to exceed sixty months.

Signed: R Stadler date 10-11-00

Improvement Permit by: RS date 10/10/00

Authorization to Construct by: RS date 10/10/00

Installed by: Statesville Backhoe Service

Operation Permit by: date 10-24-00

Existing System Inspection by: date

HEALTH DEPT. COPY: WHITE OWNER COPY (FINAL): YELLOW OWNER COPY (INITIAL): PINK