IREDELL COUNTY HEALTH DEPARTMENT

Statesville Office (704) 878-5305 Mooresville Office (704) 660-3625 PERMIT # 222474

IMPROVEMENT PERMIT / AUTHORIZATION TO CONSTRUCT / OPERATION PERMIT / EXISTING SYSTEM

PIN # 4777596001

APPLICANT: Ricky Darnell APPLICANT ADDRESS: 740 Bost Street Statesville NC

SITE ADDRESS: 474 White Oak Branch Road Statesville NC PHONE: 704 682 8992 ALT. PHONE: 704-437 3374

SITE DIRECTIONS: I-40 exit 154, North on old Mocksville, 6 miles to White Oak Branch Rd Turn Right House 1/4 mile on Left

SUBDIVISION: N/A SECTION: N/A LOT # N/A LOT AREA: 1 Acre DESIGN FLOW: Ex L.T.A.R.: Ex

Septic Tank Ex (gal) STB Date
Pump Tank (gal) PT Date
Pump Make Model Serial #
Nitrification Fields Ex # Lines Ex Linear Ft: Ex
Trench Width Ex Max. Trench Bottom Depth Ex Gravel Depth Ex


☐ New System ☐ Repair ☐ Expansion System Type: I II III IV V VI
System Description: Existing
Repair System Description:
Maintenance Agreement Required: ☐ YES ☒ NO ☒ GRAVITY ☐ PRESSURE

☒ Residence No. Bedrooms Ex
☐ Business No. Persons Ex
☐ Other No. Employees
☐ Slab ☒ Crawl Space
☐ Basement w/plumbing ☐ Basement w/o plumbing


Water Supply
☒ Private
☐ Public
☐ Community

Comments / Conditions: Maintain 5ft from any part of the septic tank and Septic system. Maintain 25ft or greater from private well.

INITIAL SITE SKETCH

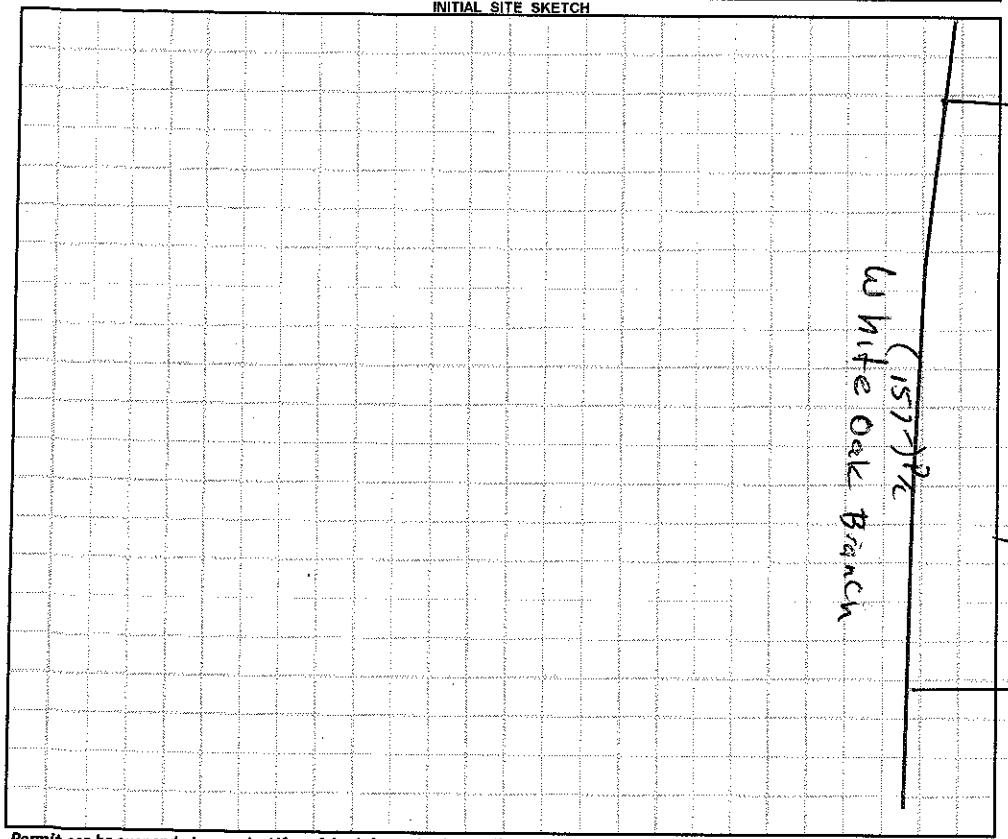

AS BUILT SKETCH

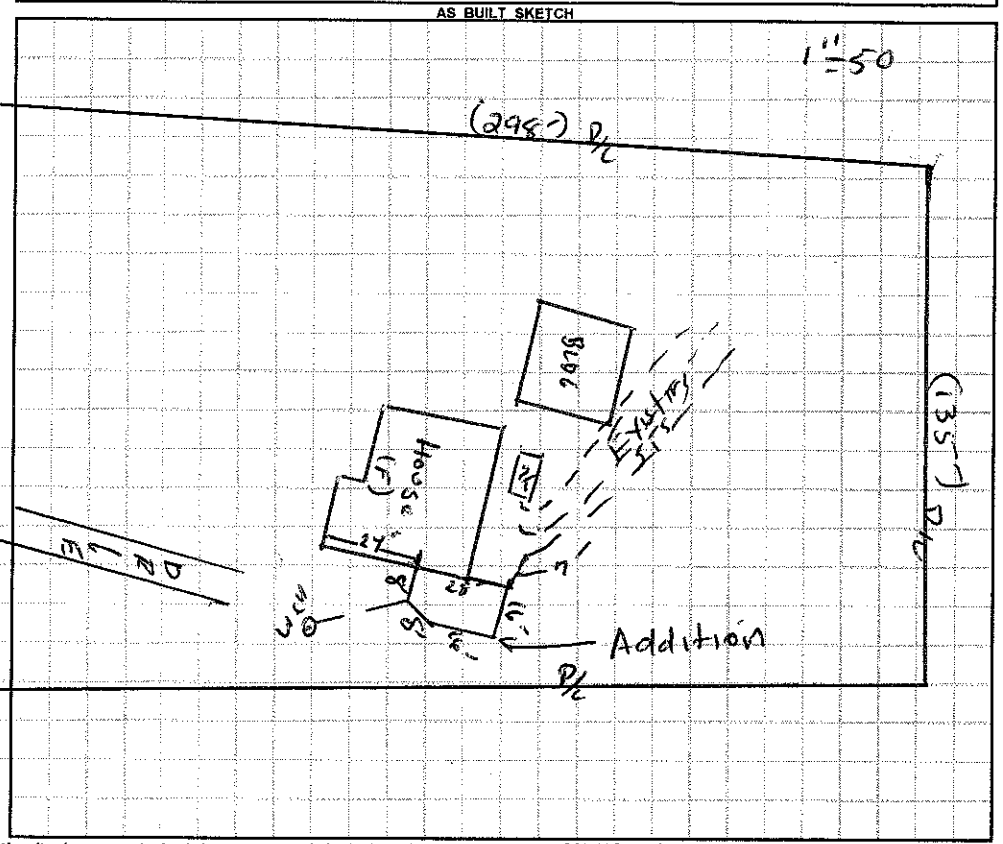

Permit can be suspended or revoked if any false information is supplied toward securing the permit / any unauthorized changes are made to the site / any unauthorized changes are made in the installation of the system. **CONTACT A LOCATOR SERVICE PRIOR TO ANY EXCAVATION**

☐ **IMPROVEMENT PERMIT** *with plat valid without expiration.* ☐ **IMPROVEMENT PERMIT** *with site plan valid for 60 mos.* ☐ **AUTHORIZATION TO CONSTRUCT** *valid for period equal to IMPROVEMENT PERMIT--not to exceed 60 mo.*

Owner / Applicant Signature: Ricky Darnell Date: 11/21/16 Installed by:

IMPROVEMENT PERMIT by: Date: OPERATION PERMIT by: Date:

AUTHORIZATION TO CONSTRUCT by: Date: Existing System Inspected by: Date: 11/30/16

Health Dept. Copy - WHITE Applicant (Final Approval) - YELLOW Applicant (Conditional Approval) - PINK