IREDELL COUNTY HEALTH DEPARTMENT

STATESVILLE 704-878-5305 MOORESVILLE 704-664-5281

IMPROVEMENT PERMIT / AUTHORIZATION TO CONSTRUCT / OPERATION PERMIT / EXISTING SYSTEM INSPECTION

PERMIT# SEE #108831 PIN# 4777-62-4484 DATE 5-30-08

OWNER OR APPLICANT CHESTNUT GROVE BAPTIST CHURCH PHONE: Business 704-500-9050 Home

ADDRESS 772 COOL SPRING ROAD STATESVILLE, NC 28625

LOCATION OLD MOCKSVILLE ROAD TO COOL SPRING ROAD, ON LEFT AT RIVER HILL ROAD

SUBDIVISION BLOCK / SECTION LOT LOT AREA 9.90 ACRES SITE CLASS. PS DESIGN FLOW 1430 L.T.A.R. EX. 0.3 GPD/FT

Septic Tank: 3000 Gallons: STB Date

Pump Tank: 2500 Gallons: PT Date

Pump Make: Model Serial No.

Nitrification Field: No Fields 1 Square Feet 4767 Linear Feet 1589

No Lines 12 Trench Width 36" Max Trench Bottom Depth 36" Gravel Depth 12" ☐ Gravity ☑ Pressure

☐ New System ☐ Repair ☐ Expansion System Type: I II III IV V VI

System Description: CONVENTIONAL, PUMP

Repair System Description: 25% REDUCTION, PUMP

Maintenance Agreement Required: ☐ Yes ☒ No

☐ House/Mod. Home No. Bedrooms

☐ Mobile Home No. Persons 50

☑ Business DAY CARE No. Employees

☑ Other CHURCH W/ 286 SEATS


Water Supply: ☐ Individual ☑ Public ☐ Community

☐ Slab ☐ Crawl Space ☑ Basement w/plumbing ☐ Basement wo/plumbing


Comments:/Conditions:

Comments:/Conditions: CHURCH W/ DAY CARE AT 50 CHILDREN MAXIMUM — NO FOOD PREPARATION — NO MORE THAN FOUR HOURS DAILY OPERATION.

INITIAL SITE SKETCH

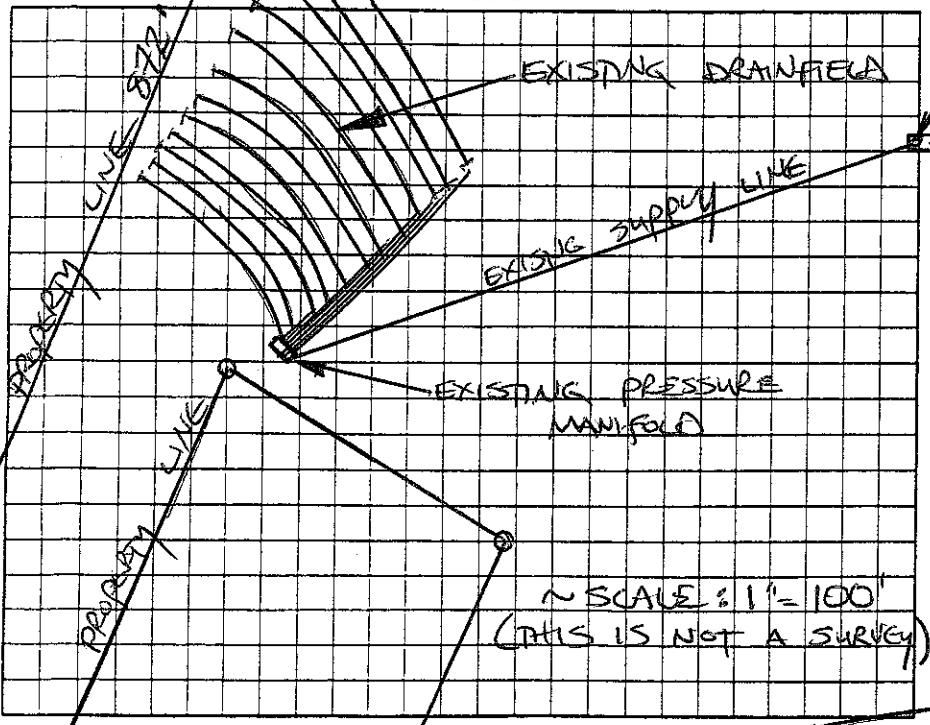

AS BUILT SKETCH

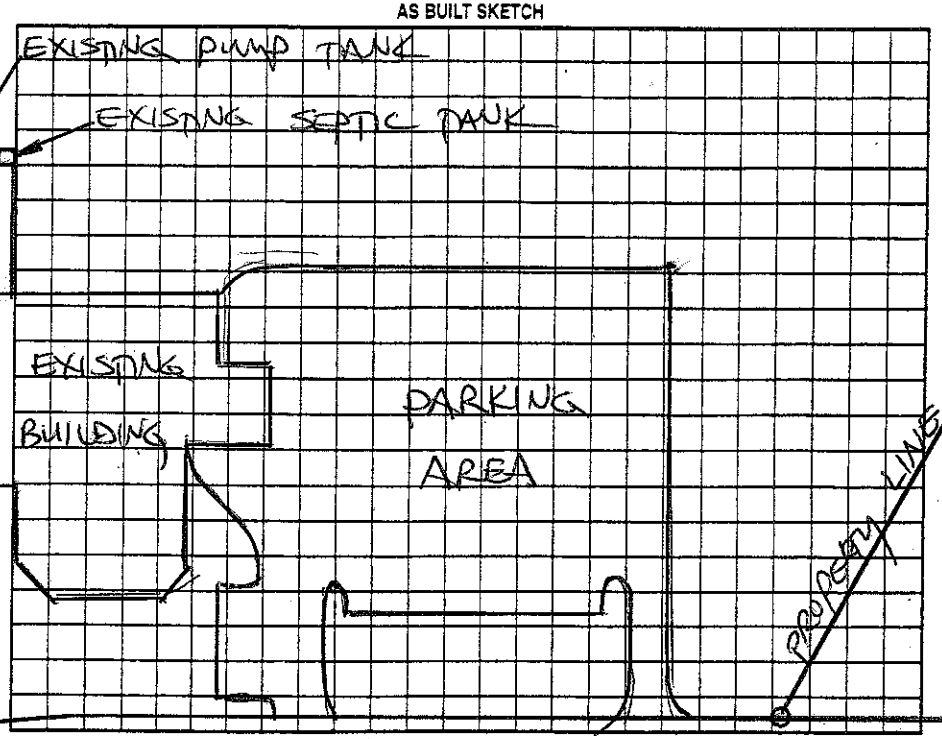

Permit can be suspended or revoked if any false information is supplied toward securing the permit/any unauthorized changes are made to the site/any unauthorized changes are made in the installation of the system. Improvement Permit with plat valid without expiration ☐ Improvement Permit with site plan valid for sixty months ☐ Authorization to Construct is valid for a period equal to that of Improvement Permit – not to exceed sixty months.

Signed: date Installed by:

Improvement Permit by: date Operation Permit by: date

Authorization to Construct by: date Existing System Inspection by: STEVE HEDRICK date 5-30-08

HEALTH DEPT. COPY: WHITE OWNER COPY (FINAL): YELLOW OWNER COPY (INITIAL): PINK